

2004 AUG 12 AM 9 25

CINDY MESSERSMITH
 COUNTY RECORDER

TEKIPPE ENGINEERING, P.C., 128 South Vine Street, West Union, Iowa 52175 Phone (563) 422-5131

UNITED STATES PUBLIC LAND SURVEY CORNER CERTIFICATE


OF
 Land Survey Monuments situated in Section 33, Township 95 North, Range
12 West of the Fifth Principal Meridian, CHICKASAW County, Iowa.
 Previously recorded in none in County Recorder's Office.
 (book, page, document number, etc.)

(Show reason for preparing this certificate, the evidence and detailed procedures used in establishing the corner positions and monumentation found or placed.)

Monument Description and Remarks: E 1/4 Corner Section 33 T95N R12W: Found 5/8" square iron bar with information obtained from the Chickasaw County Engineer's Office in Field Book New Hampton Twp. Corner Ties, Section 33, Corner 'C'.
S 1/4 Corner Section 33 T95N R12W: Found 5/8" square iron pin, 2' deep, with information obtained from the Chickasaw County Engineer's Office in Field Book New Hampton Twp., Section 33, Corner 'A'. Set 1/2"Ø rebar w/2"Ø aluminum cap PLS 16961 over iron bar.

PLAN - VIEW

(Show a minimum of three reference ties to durable physical objects, relevant monuments and physical conditions that will enable recovery of the corner.)

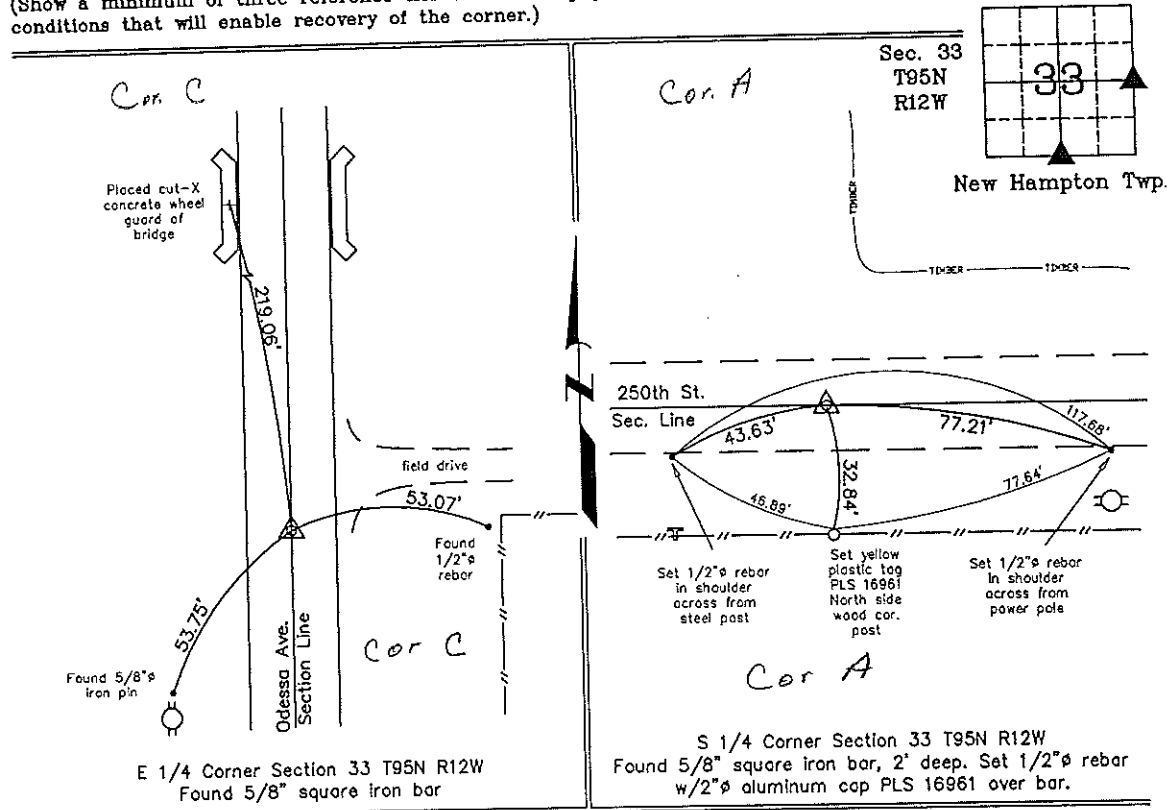

E 1/4 Corner Section 33 T95N R12W
 Found 5/8" square iron bar

S 1/4 Corner Section 33 T95N R12W
 Found 5/8" square iron bar, 2' deep. Set 1/2"Ø rebar w/2"Ø aluminum cap PLS 16961



I hereby certify that this land surveying document was prepared and the related survey work was performed by me or under my direct personal supervision and that I am a duly licensed Land Surveyor under the laws of the State of Iowa.

Michael J. Shimak August 11, 2004
 Michael J. Shimak Date

License number 16961
 My license renewal date is December 31, 2005.
 Sheets covered by this seal: Individual

List Corners to be Indexed			
Corners	Section	Twp.	Range
E 1/4	33	95N	12W
S 1/4	33	95N	12W

X:\Section Corners\Sec. 33\33-95-12ow.dwg
 Project Number 04168.LS
 FB. 48K PG. 61-66