

Chickasaw Co. Recorder
 Cindy Messersmith
Fee Book 2014-1840
 12/30/2014 @0838AM
 SCC: SEC COR CERT
 Book: Page: # Pages: 1
 Total Fees: \$7.00

Prepared by & Return to: Herold - Reicks Surveying, 10 East Main Street, New Hampton, IA 50659, Ph. 641-394-2725

UNITED STATES PUBLIC LAND SURVEY CORNER CERTIFICATE

Land Survey Monuments situated in Section 34, Township 95 North, Range 12 West of the Fifth Principal Meridian, Chickasaw County, Iowa. 1.) Previously recorded in Bk. 150, Pg. 371 in the County Recorder's office. 2.) Previously not recorded in the County Recorder's office.

This certificate is being prepared in compliance with Iowa Code Chapter 355.11 because:


- 2 There is no certificate on file for this corner.
- There are no longer three valid ties of record.
- 1 There are changes to reference ties of record.
- There is change of monumentation of record.
- To clarify description of record monument (ties).

Monument Description and Remarks:

- 1.) **North 1/4 Corner:** Found PK Nail with information obtained from the previous Section Corner Certificate, Bk. 150, Pg. 371 and from the County Engineer's Office.
- 2.) **Northeast Corner NW 1/4-NE 1/4:** Set survey mark nail w/stainless steel washer PLS 22468 equidistant and online between the North 1/4 and Northeast Corners of Section 34.

PLAN - VIEW

(Show a minimum of three reference ties to durable physical objects, relevant monuments and physical conditions that will enable recovery of the corner.)

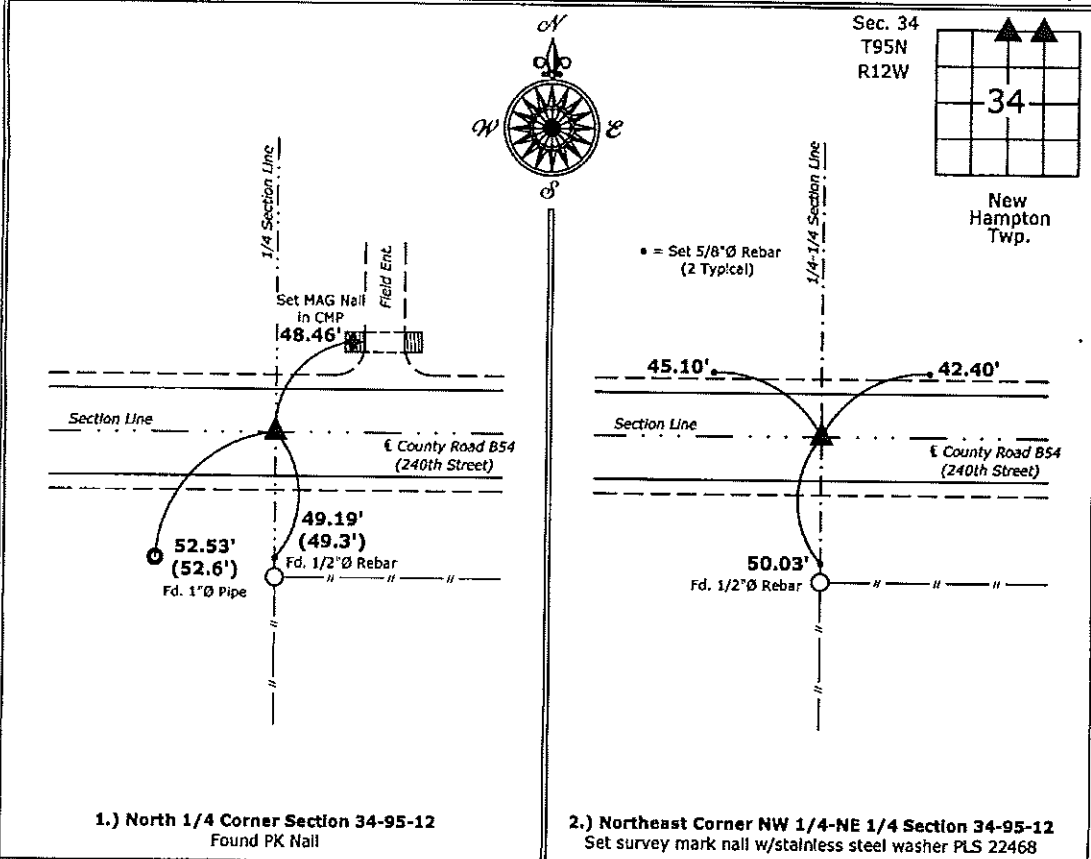

1.) North 1/4 Corner Section 34-95-12
 Found PK Nail

2.) Northeast Corner NW 1/4-NE 1/4 Section 34-95-12
 Set survey mark nail w/stainless steel washer PLS 22468



I hereby certify that this land surveying document was prepared and the related survey work was performed by me or under my direct personal supervision and that I am a duly licensed Land Surveyor under the laws of the State of Iowa.
Isaiah M. Reicks 12-29-14
 Isaiah M. Reicks Date:
 License number 22468
 My license renewal date is December 31, 2014.
 Sheets covered by this seal: Individual sheet only

List Corners to be Indexed			
Corners	Section	Twp.	Range
N 1/4	34	95	12
NE-NW-NE	34	95	12

Project Number: 2014-248
 FB: Chickasaw County 6, Pgs. 67-68

File: S:_CSD Projects\County Control Systems\CHICKASAW\CHICK-35\CHICK-35.dwg, 12/29/2014 1:30:02 PM