

Recorded: 5/8/2019 at 11:43:53.0 AM
 Pages 1
 County Recording Fee: \$7.00
 Iowa E-Filing Fee: \$3.00
 Combined Fee: \$10.00
 Revenue Tax:
 Shirley Troyna RECORDER
 Chickasaw County, Iowa

Prepared by & Return to: Herold - Reicks Surveying, 2206 East Bremer Avenue, Waverly, IA 50677, Ph. 319-483-5107

United States Public Land Survey Corner Certificate

Land Survey Monument situated in
 Section 36, Township 94 North, Range 12 West of the Fifth Principal Meridian, Chickasaw County, Iowa.
 On file in Document #2003-3777 in the County Recorder's office.

This certificate is being prepared in compliance with Iowa Code Chapter 355.11 because:


- There is no certificate on file for this corner.
- There are no longer three valid ties of record.
- There are changes to reference ties of record.
- There is change of monumentation of record.
- To clarify description of record monument (ties).

Monument Description and Remarks:

South 1/4 Corner: Found Nail Shaft. Removed and reset Survey Mark Nail w/Stainless Steel Washer PLS 22468 at said found location with information obtained from the previously recorded Section Corner Certificate.

Plan View

(Show a minimum of three reference ties to durable physical objects, relevant monuments and physical conditions that will enable recovery of the corner.)

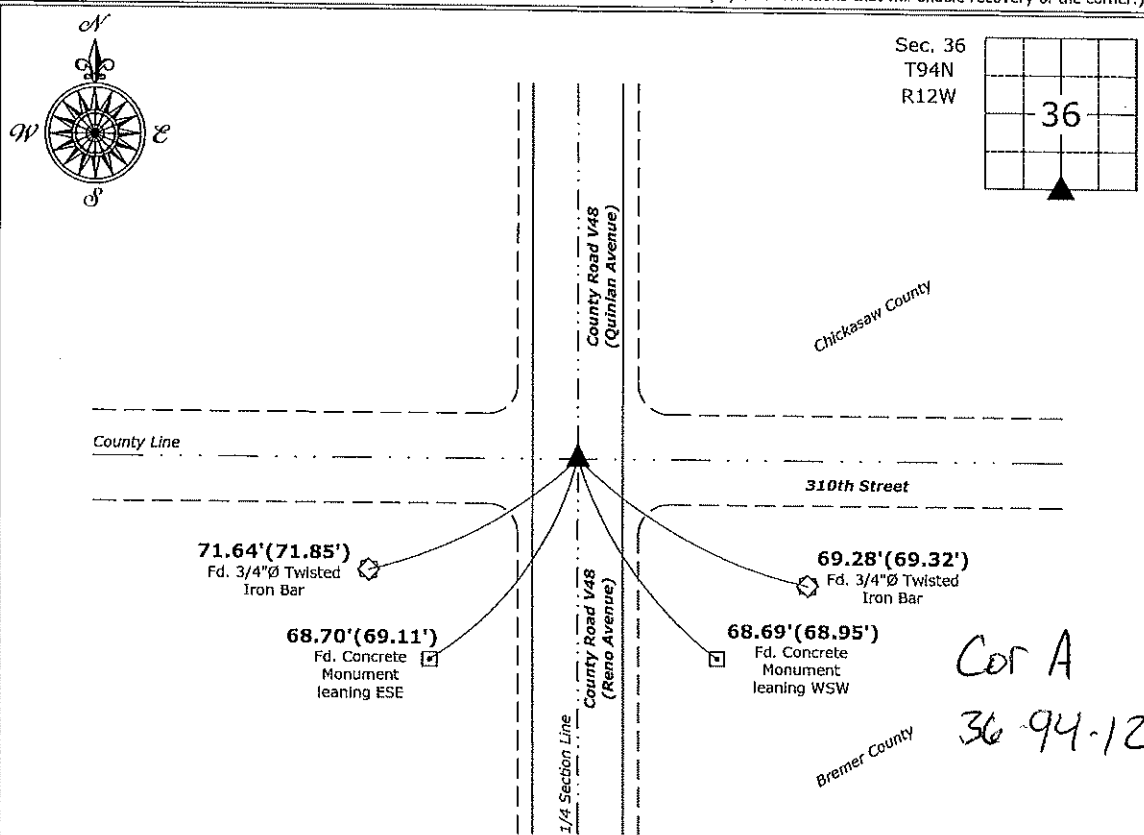

South 1/4 Corner of Section 36-94-12
 Found Nail Shaft. Reset Survey Mark Nail w/Stainless Steel Washer PLS 22468



I hereby certify that this land surveying document was prepared and the related survey work was performed by me or under my direct personal supervision and that I am a duly licensed Land Surveyor under the laws of the State of Iowa.

Isaiah M. Reicks 5-7-19
 Isaiah M. Reicks Date:

License number 22468
 My license renewal date is December 31, 2019.
 Sheets covered by this seal: Individual sheet only

List Corner to be Indexed

Corner	Section	Twp.	Range
S 1/4	36	94	12

Project Number: 2019-524

FB: Bremer 14, Pgs. 15-16

File: I:\Projects - WQ\County Control Systems\WQ\BREMER\BREMER-3 (Frederika)\BREMER-3.dwg, 5/7/2019 11:20:33 AM