

Section 25-95-12
 As referred to in
 Engr Trc Book

Chickasaw Co. Recorder
 Cindy Messersmith
Fee Book 2009-0253
 02/03/2009 @1035AM
 SCC SEC COR CERT
 Book: Page: # Pages: 1
 Total Fees: \$7.00

Herold - Reicks Surveying, 25 1/2 East Main Street, Suite 204, New Hampton, IA 50659, Ph. 641-394-2725

UNITED STATES PUBLIC LAND SURVEY CORNER CERTIFICATE

Land Survey Monuments situated in Section ²⁵ 36, Township 95 North, Range 12 West of the Fifth Principal Meridian, Chickasaw County, Iowa. Not previously recorded in the County Recorder's office.

This certificate is being prepared in compliance with Iowa Code Chapter 355.11 because:


- There is no certificate on file for this corner.
- There are no longer three valid ties of record.
- There are changes to reference ties of record.
- There is change of monumentation of record.
- To clarify description of record monument (ties).

Monument Description and Remarks:

North 1/4 Corner: County Engineer's notes indicates PK Nail at the intersection of Quinian Avenue and County Road B54. After comparing distances to adjacent corners in the surrounding Section, I have concluded the existing PK Nail is in fact a point on the Centerline Tangent (POT). Set Survey Mark Nail with Stainless Steel Washer PLS 19211 in the Centerline of County Road B54 by doubling the distance from the Northwest Corner to a position at the Northeast Corner of the NW 1/4-NW 1/4 and online between the Northwest Corner and said POT.

PLAN - VIEW

(Show a minimum of three reference ties to durable physical objects, relevant monuments and physical conditions that will enable recovery of the corner.)

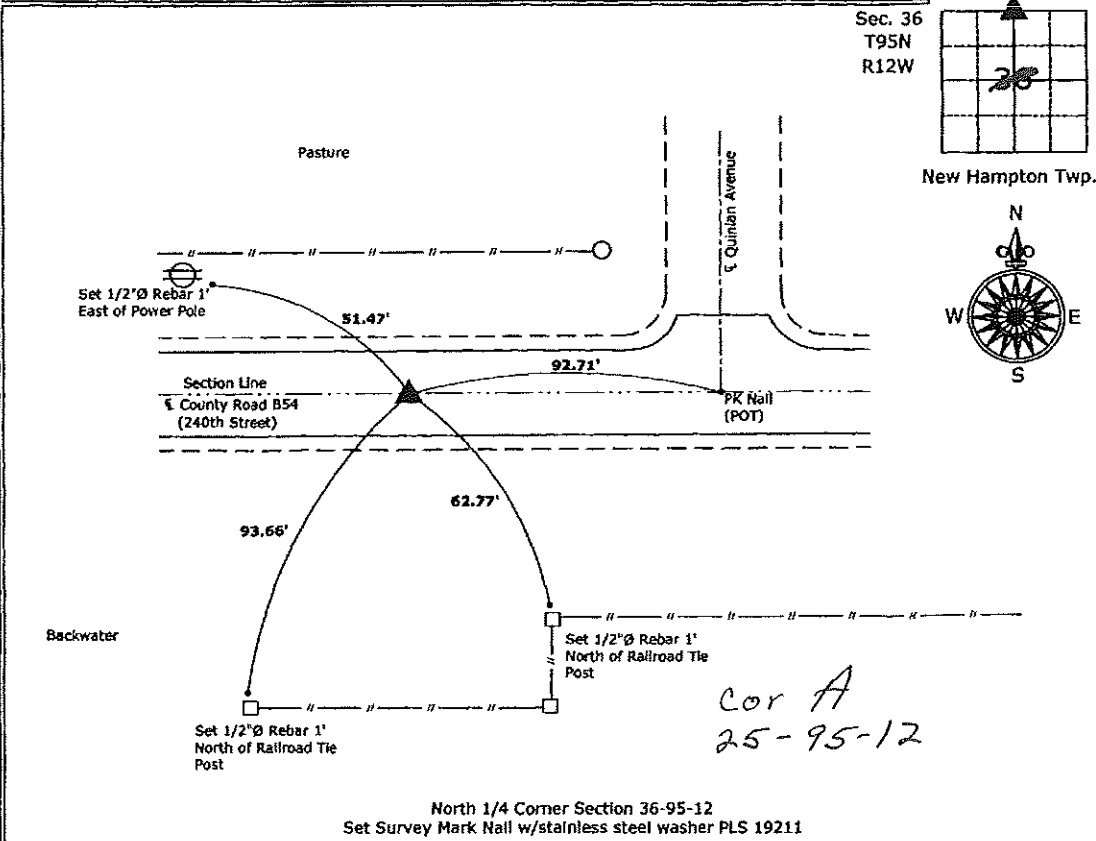

I hereby certify that this land surveying document was prepared and the related survey work was performed by me or under my direct personal supervision and that I am a duly licensed Land Surveyor under the laws of the State of Iowa.
Kirk D. Reicks 2-3-09
 Kirk D. Reicks Date:
 License number 19211
 My license renewal date is December 31, 2010.
 Sheets covered by this seal: Individual sheet only

List Corners to be Indexed			
Corners	Section	Twp.	Range
N 1/4	36	95	12

Project Number: 2009-009
 FB: Chickasaw County 3, Pgs. 20

File: S:_Projects\2009-009\dwg\2009-009.dwg, 2/2/2009 5:19:30 PM