


Section 34-96-12
 As referred to in
 Engr. The Book

Chickasaw Co. Recorder
 Cindy Messersmith
Fee Book 2009-0914
 05/05/2009 @12:27PM
 PS PLAT OR SURVEY
 Book: Page: # Pages: 1
 Total Fees: \$7.00

Prepared by Herold - Reicks Surveying, 25 1/2 East Main Street, Suite 204, New Hampton, IA 50659, Ph. 641-394-2725

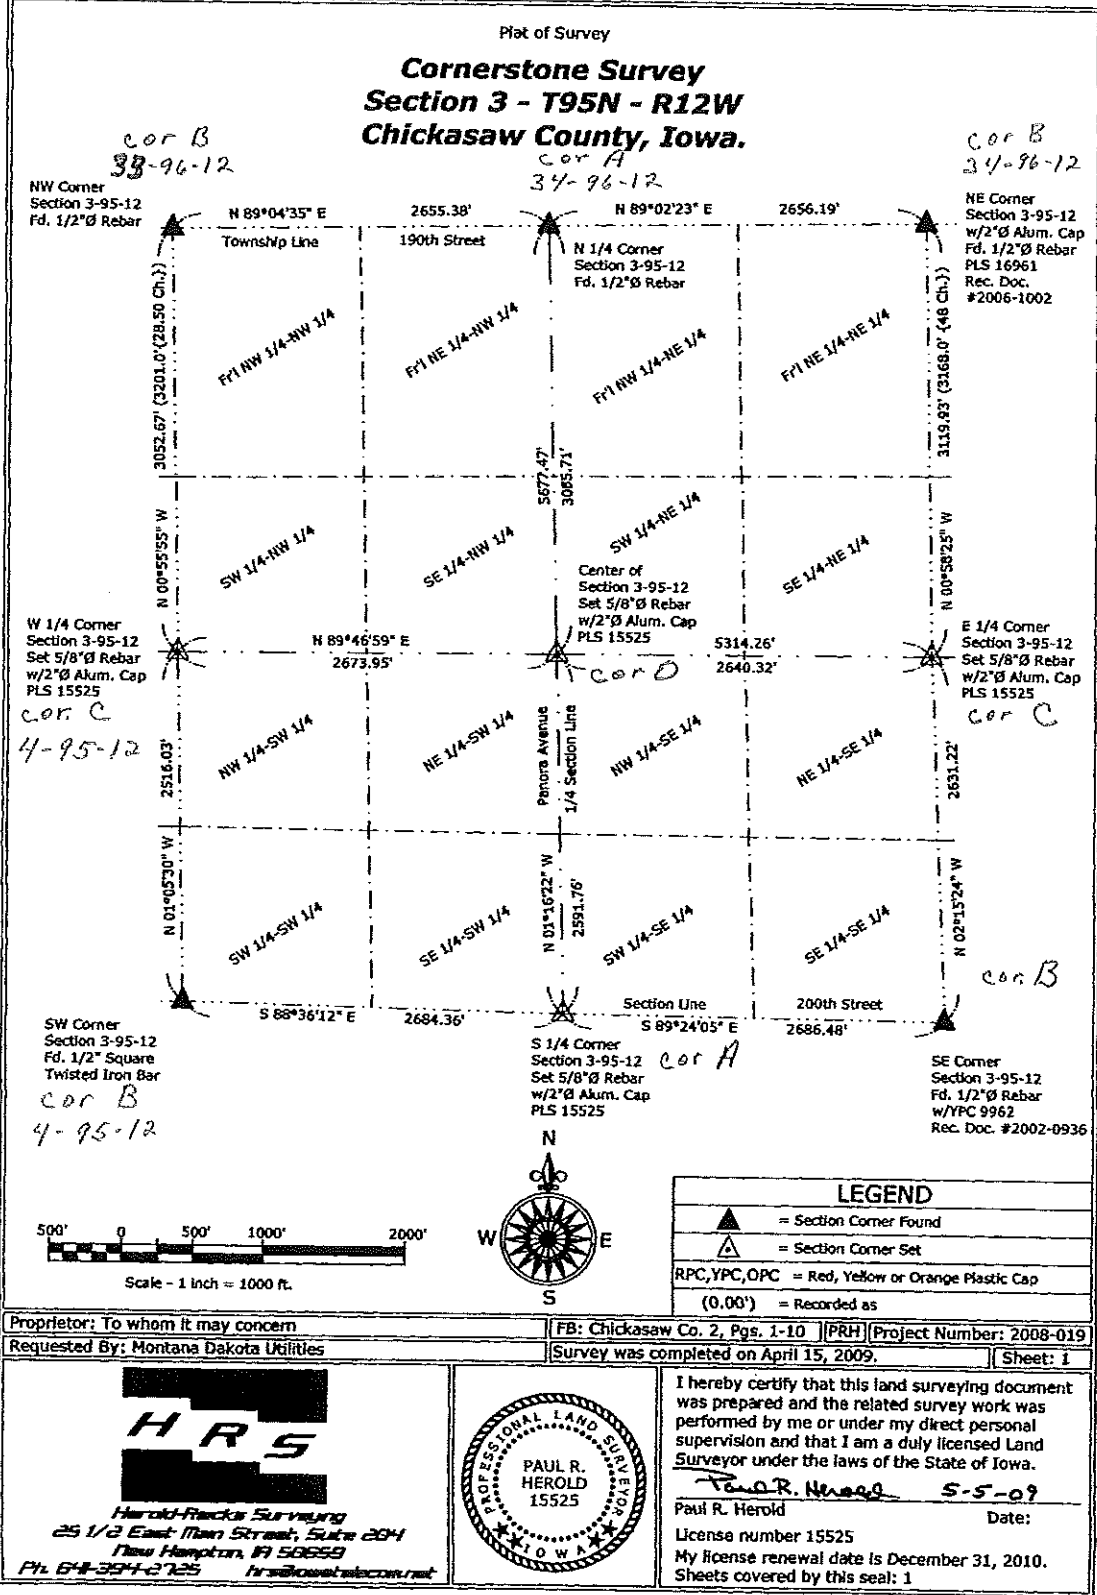


File: S:\Projects\2008\2008-019\wp\2008-019.dwg, 5/5/2009 09:43:21

Section 34-96-12
As referred to in
Eng. Trc Book

Chickasaw Co. Recorder
Cindy Messersmith
Fee Book 2009-0915
05/05/2009 @1230PM
PS PLAT OR SURVEY
Book: Page: # Pages: 1
Total Fees: \$7.00

Prepared by Herold - Reicks Surveying, 25 1/2 East Main Street, Suite 204, New Hampton, IA 50659, Ph. 64-394-2725

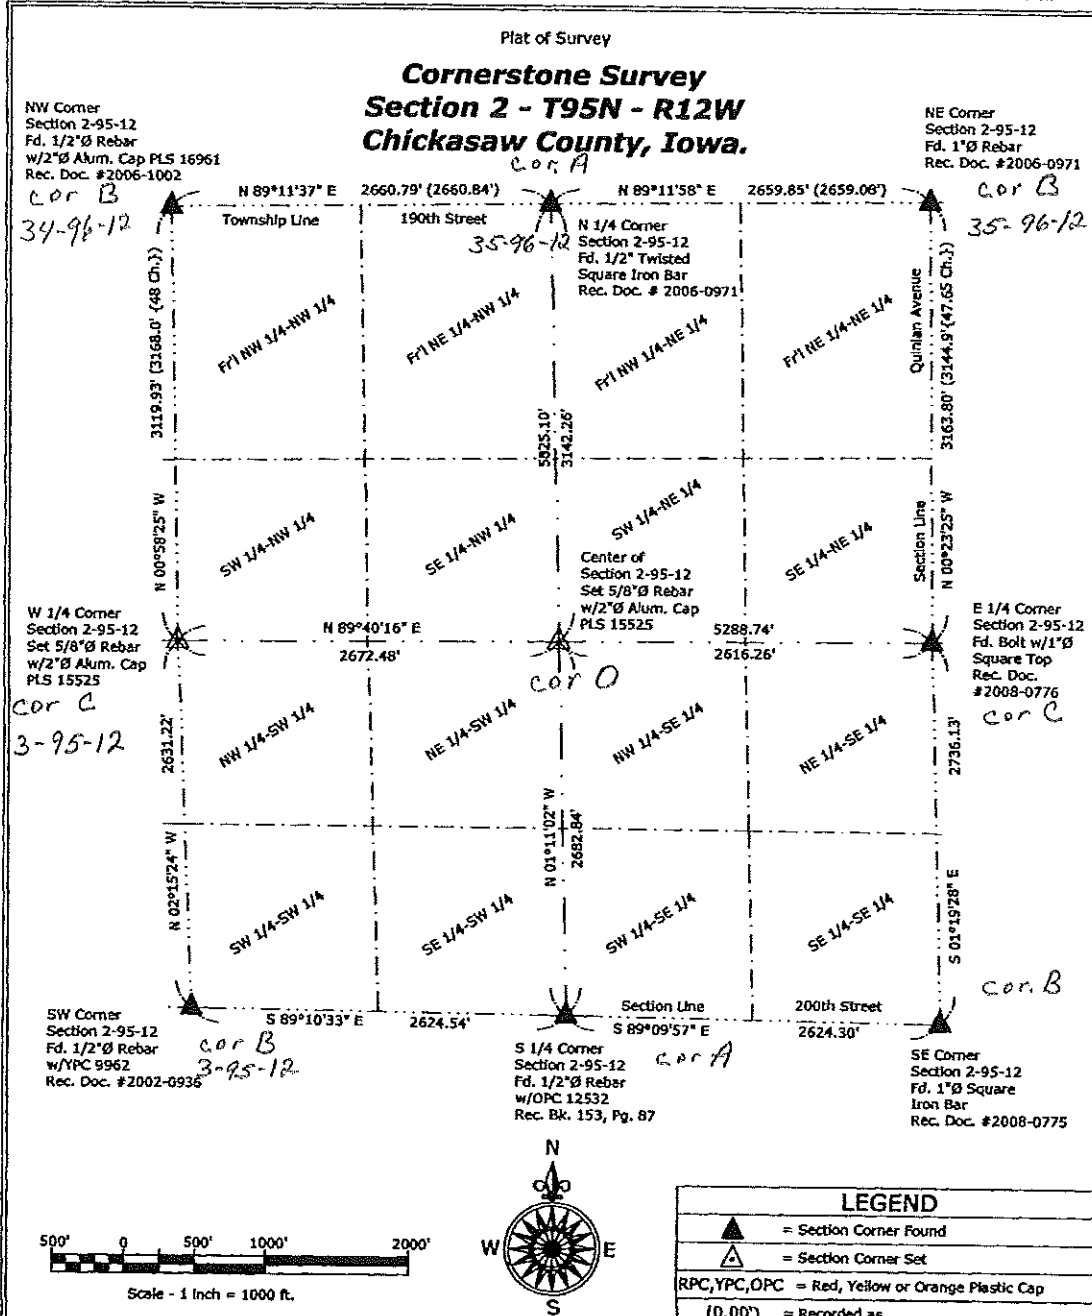

File: S:_Projects\2008-019.dwg, 5/15/2009 09:43:05

Proprietor: To whom it may concern
Requested By: Montana Dakota Utilities
FB: Chickasaw Co. 2, Pgs. 1-10 [PRH] Project Number: 2008-019
Survey was completed on April 15, 2009. Sheet: 1

Herold-Reicks Surveying
25 1/2 East Main Street, Suite 204
New Hampton, IA 50659
Ph. 64-394-2725
hrsl@comcast.net

PROFESSIONAL LAND SURVEYOR
PAUL R. HEROLD
15525
IOWA

I hereby certify that this land surveying document was prepared and the related survey work was performed by me or under my direct personal supervision and that I am a duly licensed Land Surveyor under the laws of the State of Iowa.

Paul R. Herold 5-5-09
Paul R. Herold Date:
License number 15525
My license renewal date is December 31, 2010.
Sheets covered by this seal: 1