

Herold - Reicks Surveying, 25 1/2 East Main Street, Suite 204, New Hampton, IA 50659, Ph. 641-394-2726

UNITED STATES PUBLIC LAND SURVEY CORNER CERTIFICATE

Land Survey Monuments situated in Section 3, Township 95 North, Range 12 West of the Fifth Principal Meridian, Chickasaw County, Iowa. Not previously recorded in the County Recorder's office.

This certificate is being prepared in compliance with Iowa Code Chapter 355.11 because:


- There is no certificate on file for this corner.
- There are no longer three valid ties of record.
- There are changes to reference ties of record.
- There is change of monumentation of record.
- To clarify description of record monument (ties).

Monument Description and Remarks:

- 1.) **Center of Section:** Set 5/8"Ø rebar w/2"Ø aluminum cap PLS 15525 at the intersection of the Quarter Section Lines, there are no records of the perpetuation of a monument at this corner, and the found monument in the vicinity is described in the Chickasaw County Engineer's Notes as set for road centerline only.
- 2.) **West 1/4 Corner:** Set 5/8"Ø rebar with 2"Ø aluminum cap PLS 15525 at an existing fence corner after comparing the position to adjacent corners in the section, there are no records of the perpetuation of a monument at this corner position.

PLAN - VIEW

(Show a minimum of three reference ties to durable physical objects, relevant monuments and physical conditions that will enable recovery of the corner.)

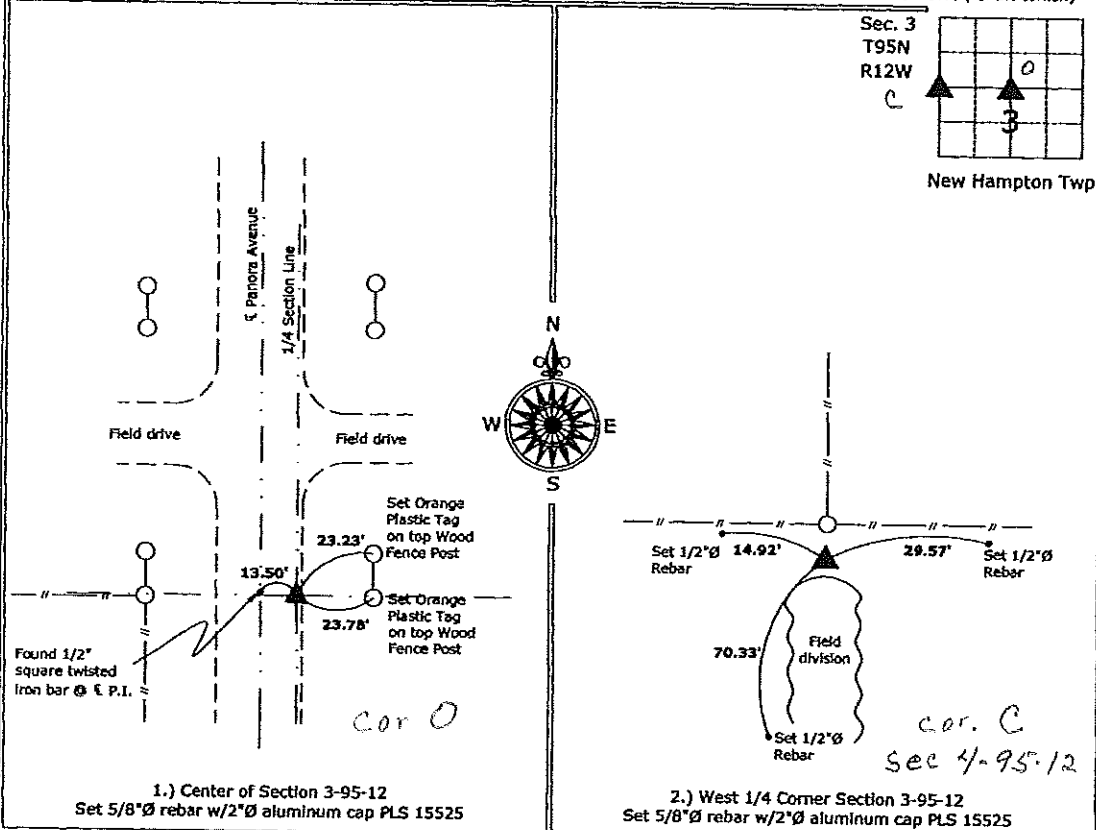

File: S:_Projects\2008\2008-019.dwg, 5/5/2009 09:30:35



I hereby certify that this land surveying document was prepared and the related survey work was performed by me or under my direct personal supervision and that I am a duly licensed Land Surveyor under the laws of the State of Iowa.

Paul R. Herold 5-5-09
 Paul R. Herold Date:
 License number 15525
 My license renewal date is December 31, 2010.
 Sheets covered by this seal: Individual sheet only


List Corners to be Indexed			
Corners	Section	Twp.	Range
CENTER	3	95	12
W 1/4	3	95	12

Project Number: 2008-019
 FB: Chickasaw County 2, Pgs. 1-10

Section 34-96-12
 As referred to in
 Engr. Trc Book

Chickasaw Co. Recorder
 Cindy Messersmith
Fee Book 2009-0914
 05/05/2009 @12:27PM
 PS PLAT OR SURVEY
 Book: Page: # Pages: 1
 Total Fees: \$7.00

Prepared by Herold - Reicks Surveying, 25 1/2 East Main Street, Suite 204, New Hampton, IA 50659, Ph. 641-394-2725

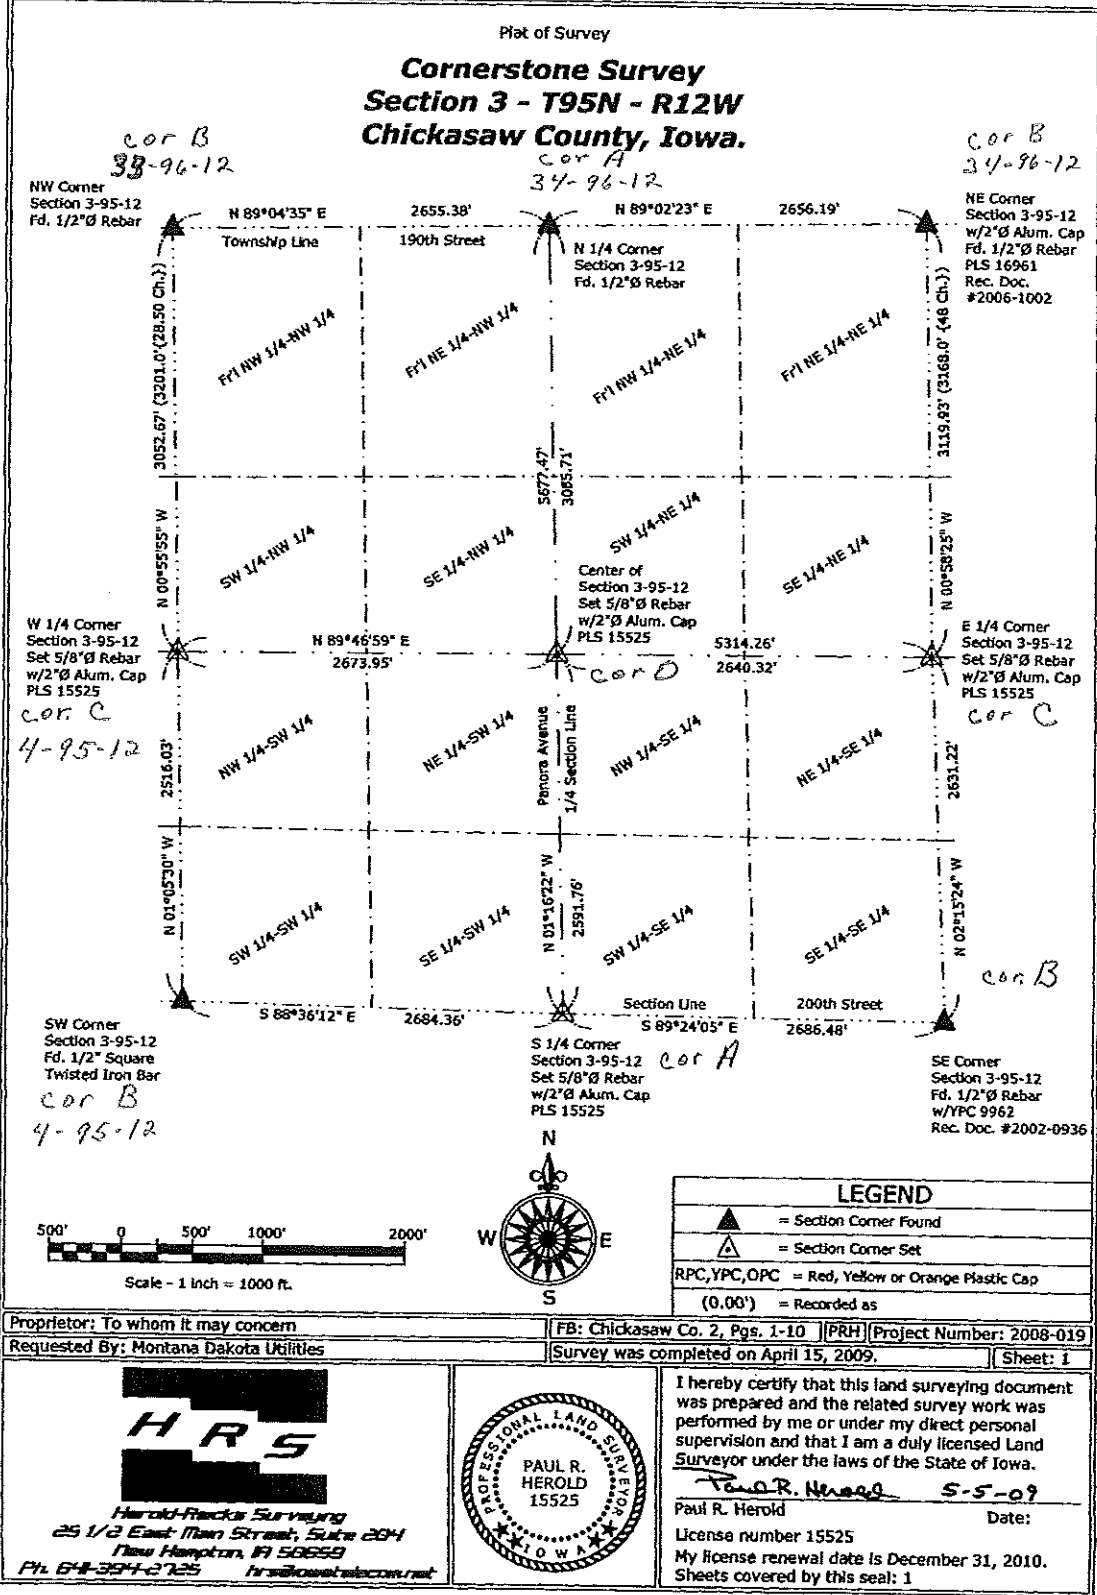

File: S:\Projects\2008\2008-019\wp\2008-019.dwg, 5/5/2009 09:43:21