

Section 5-95-12
As referred to in
Engr. T.C. Book

FILED 2005-2340
RECORDER'S OFFICE
CHICKASAW COUNTY, IOWA

2005 OCT 24 AM 10 16

CINDY MESSERSMITH
COUNTY RECORDER

TEKIPPE ENGINEERING, P.C., 128 South Vine Street, West Union, Iowa 52175 Phone (563) 422-5131

UNITED STATES PUBLIC LAND SURVEY CORNER CERTIFICATE

OF 5



Land Survey Monuments situated in Section 4, Township 95 North, Range 12 West of the Fifth Principal Meridian, CHICKASAW County, Iowa. Previously recorded in (1) none (2) Bk. 160 Pg. 445 in County Recorder's Office. (book, page, document number, etc.)

(Show reason for preparing this certificate, the evidence and detailed procedures used in establishing the corner positions and monumentation found or placed.)

Monument Description and Remarks: (1) N 1/4 CORNER SECTION 4 T95N R12W: Found 1/2" iron pin with information obtained from the Chickasaw County Engineer's Office in Field Book Jacksonville Twp. Corner Ties, Section 33-96-12, Corner 'A'. (2) W 1/4 CORNER SECTION 4 T95N R12W: Found 1/2" rebar w/yellow plastic cap 11442 with information obtained from the previous Section Corner Certificate recorded in the Chickasaw County Recorder's Office in Book 160, Page 445, E 1/4 Corner, Section 5-95-12. All previous reference ties were missing. Added three reference ties.

PLAN - VIEW

(Show a minimum of three reference ties to durable physical objects, relevant monuments and physical conditions that will enable recovery of the corner.)

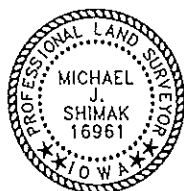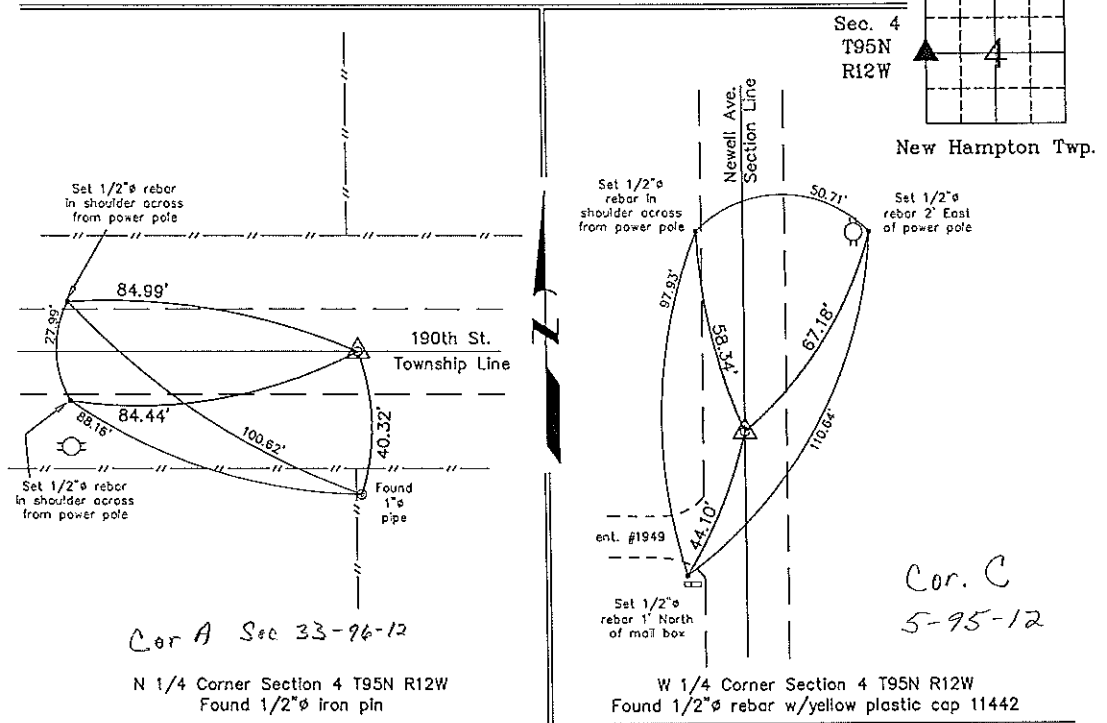

I hereby certify that this land surveying document was prepared and the related survey work was performed by me or under my direct personal supervision and that I am a duly licensed Land Surveyor under the laws of the State of Iowa.

Michael J. Shimak October 21, 2005
Michael J. Shimak Date

License number 16961
My license renewal date is December 31, 2005.
Sheets covered by this seal: Individual

List Corners to be Indexed			
Corners	Section	Twp.	Range
N 1/4	4	95N	12W
W 1/4	4	95N	12W

Project Number 05223.LS
FB. New Hampton #2 PG. 5-6
X:\Section Corners\Sec. 044-95-12ck.dwg