

>

Chickasaw Co. Recorder
Cindy Messersmith
Fee Book 2008-1135
06/12/2008 00346PM
SCC SEC COR CERT
Book: Page: # Pages: 1
Total Fees: \$7.00

Herold - Reaks Surveying, 25 1/2 East Main Street, Suite 204, New Hampton, IA 50659, Ph. 641-394-2725

UNITED STATES PUBLIC LAND SURVEY CORNER CERTIFICATE

Land Survey Monuments situated in:

Section **6**, Township **95** North, Range **12** West of the Fifth Principal Meridian, **Chickasaw** County, Iowa. Previously recorded in Book 156, Page 465 in the County Recorder's Office.


(Show reason for preparing this certificate, the evidence and detailed procedures used in establishing the corner positions and monumentation found or placed.)

Monument Description and Remarks:

Center of Section 6-95-12; Set MAG Nail w/Stainless Steel Washer PLS 15525 from information on a survey and plat made by Paul R. Herold, recorded October 22, 2001, Doc. #2001-2291, on file in the Chickasaw County Recorder's Office, New Hampton, Iowa.

PLAN - VIEW

(Show a minimum of three reference ties to durable physical objects, relevant monuments and physical conditions that will enable recovery of the corner.)

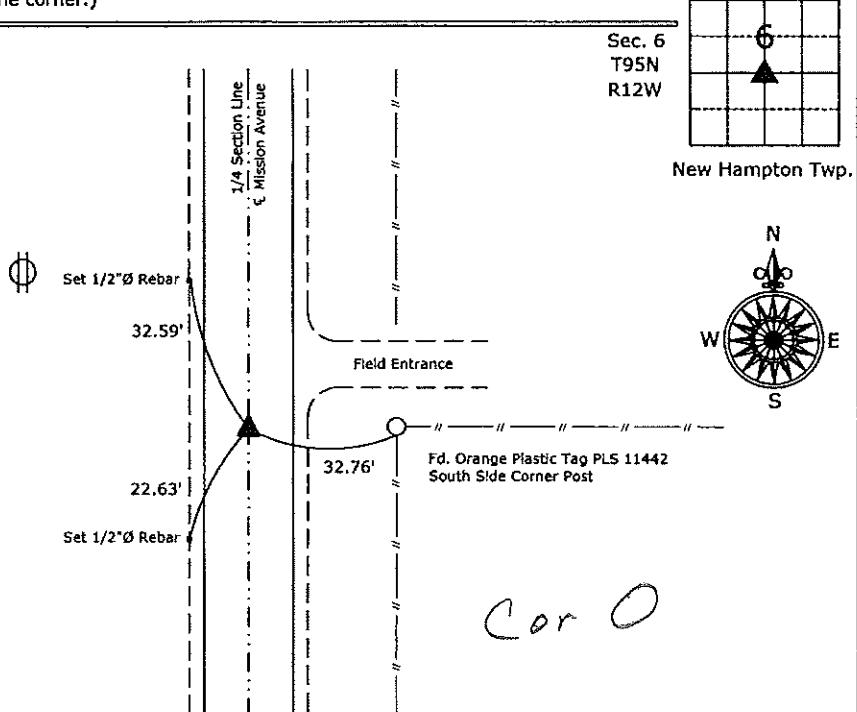

Center of Section 6-95-12
Set MAG Nail w/Stainless Steel Washer PLS 15525



I hereby certify that this land surveying document was prepared and the related survey work was performed by me or under my direct personal supervision and that I am a duly licensed Land Surveyor under the laws of the State of Iowa.

Paul R. Herold 6-12-08

Paul R. Herold

License number 15525

My license renewal date is December 31, 2008.
Sheets covered by this seal: Individual sheet only

List Corners to be Indexed			
Corners	Section	Twp.	Range
Center	6	95	12

Project Number: 2008-053

FB: Chickasaw County 1, Pgs. 70-71

UNITED STATES PUBLIC LAND SURVEY CORNER CERTIFICATE SLSI 9-90

OF


Land Survey Monuments situated in Section 6, Township 25N,
 Range 12W, of the Fifth Principal Meridian, Chickasaw,
 County, Iowa. Previously recorded in does not apply in
 County Recorders Office. (book, page, document number, etc.)

(Show reason for preparing this certificate, the evidence and detailed procedures used in
 establishing the corner positions and monumentation found or placed.)

Monument Description and Remarks: see below

PLAN - VIEW
 (Show a minimum of three reference ties to durable physical objects, relevant monuments and
 physical conditions that will enable recovery of the corner.)

C.C. Rd. PK. 1011.2 old Hwy 63

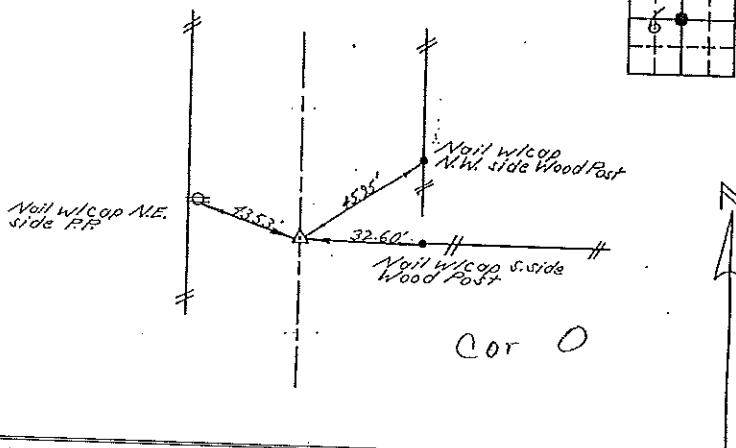

I hereby certify that the survey work was completed and this certificate was prepared by me or under my direct personal supervision and that I am a duly registered land surveyor under the laws of the State of Iowa.

Signature Lindsay Erdman
 Lindsay Erdman, P.E. & L.S.

Date 12-20-94 Reg. No. 11442

My license will be renewed January 1, 1997.

SEAL

List Corners to be Indexed
 Section 6 Twp. 25 Range 12



DOCUMENT NO.	01169	FILED FOR RECORD THE	6th	DAY OF	STATE OF IOWA, CHICKASAW COUNTY
RECORDING FEE	\$ 6.00	January	1995	AT	Lindsay Erdman, Recorder
TRANSFER FEE	\$ 0.56	old A.M. Rock	9:39		12/20/94
			PAGE 465		Deputy
				# 99125	Blottt