

Herold - Recks Surveying, 10 East Main Street, New Hampton, IA 50659, Ph. 641-394-2725, Fax. 641-394-2718

**UNITED STATES PUBLIC LAND SURVEY CORNER CERTIFICATE**

Land Survey Monuments situated in Section 8, Township 95 North, Range 12 West of the Fifth Principal Meridian, Chickasaw County, Iowa. 1.) Previously recorded in Doc. #2001-1718 in the Chickasaw County Recorder's office. 2.) Not previously recorded.

This certificate is being prepared in compliance with Iowa Code Chapter 355.11 because:

- 2.)  There is no certificate on file for this corner.
- There are no longer three valid ties of record.
- There are changes to reference ties of record.
- 1.)  There is change of monumentation of record.
- To clarify description of record monument (ties).


**Monument Description and Remarks:**

1.) **Center of Section:** Fd. Survey Mark Nail w/Stainless Steel Washer I.D.O.T. from the ties on the previous corner certificate, the previous monument was reset by the Iowa Department of Transportation after the HMA overlay project.

2.) **SW Corner SE 1/4-NW 1/4:** Set Survey Mark Nail w/Stainless Steel Washer PLS 15525 equidistant and on line between the W 1/4 Corner and the center of the section.

**PLAN - VIEW**

(Show a minimum of three reference ties to durable physical objects, relevant monuments and physical conditions that will enable recovery of the corner.)

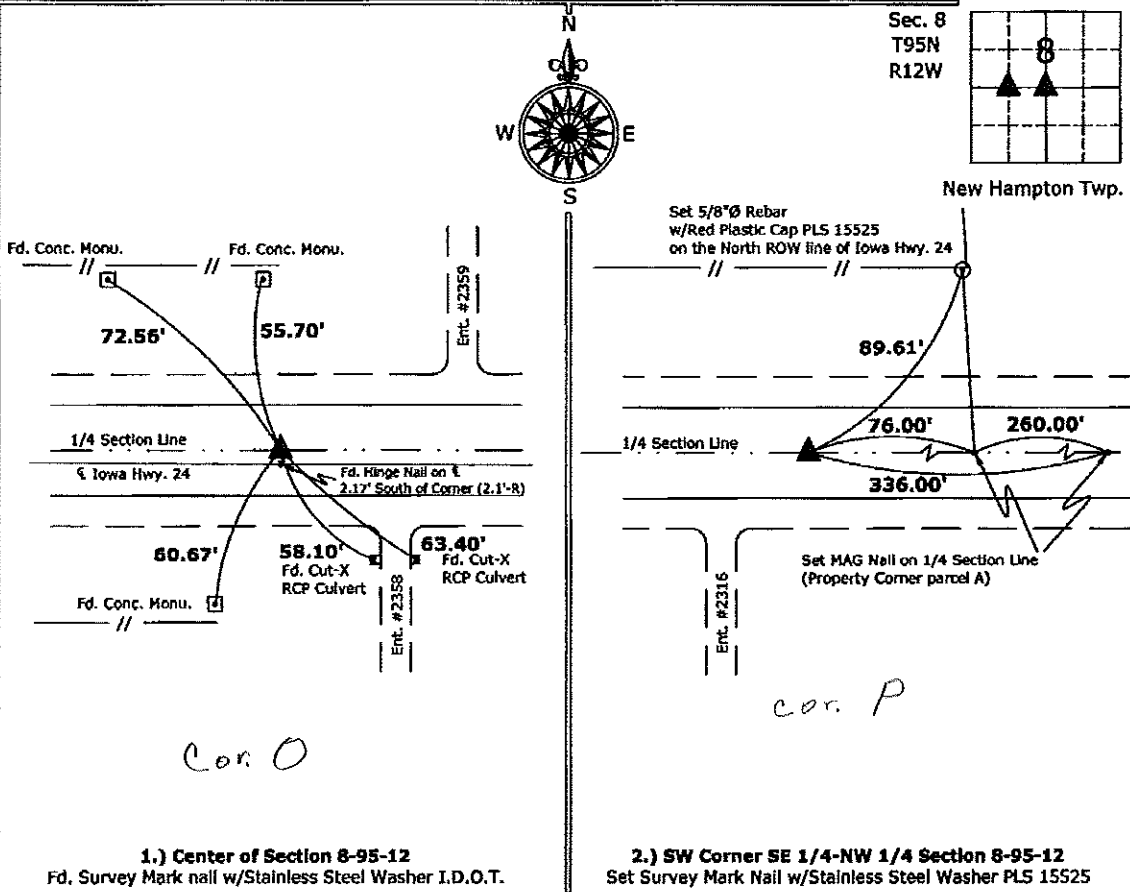

1.) **Center of Section 8-95-12**  
 Fd. Survey Mark nail w/Stainless Steel Washer I.D.O.T.

2.) **SW Corner SE 1/4-NW 1/4 Section 8-95-12**  
 Set Survey Mark Nail w/Stainless Steel Washer PLS 15525



I hereby certify that this land surveying document was prepared and the related survey work was performed by me or under my direct personal supervision and that I am a duly licensed Land Surveyor under the laws of the State of Iowa.

*Paul R. Herold* 7-9-10  
 Paul R. Herold Date:

List Corners to be Indexed			
Corners	Section	Twp.	Range
Center	8	95	12
SW-SE-NW	8	95	12

Projects\New Hampton.dwg\New Hampton.dwg, 7/18/2010 12:45:11