

Chickasaw Co. Recorder
 Cindy Messersmith
 Fee Book 2012-0102
 01/13/2012 01028AM
 SCC SEC COR CERT
 Book: Page: # Pages: 1
 total Fees: \$7.00

Prepared by & Return to: Reicks Surveying, 13 East Main Street, New Hampton, IA 50656, Ph. 641-394-2725

UNITED STATES PUBLIC LAND SURVEY CORNER CERTIFICATE

Land Survey Monuments situated in Section 8, Township 95 North, Range 14 West of the Fifth Principal Meridian, Chickasaw County, Iowa. Corner was not previously recorded in the County Recorder's office.

This certificate is being prepared in compliance with Iowa Code Chapter 355.11 because:


- There is no certificate on file for this corner.
- There are no longer three valid ties of record.
- There are changes to reference ties of record.
- There is change of monumentation of record.
- To clarify description of record monument (ties).

Monument Description and Remarks:

Northeast Corner - NW 1/4 - NW 1/4: Cut "X" in PCC Pavement equidistant and online between the North 1/4 and Northwest Corners of Section 8.

PLAN - VIEW

(Show a minimum of three reference ties to durable physical objects, relevant monuments and physical conditions that will enable recovery of the corner.)

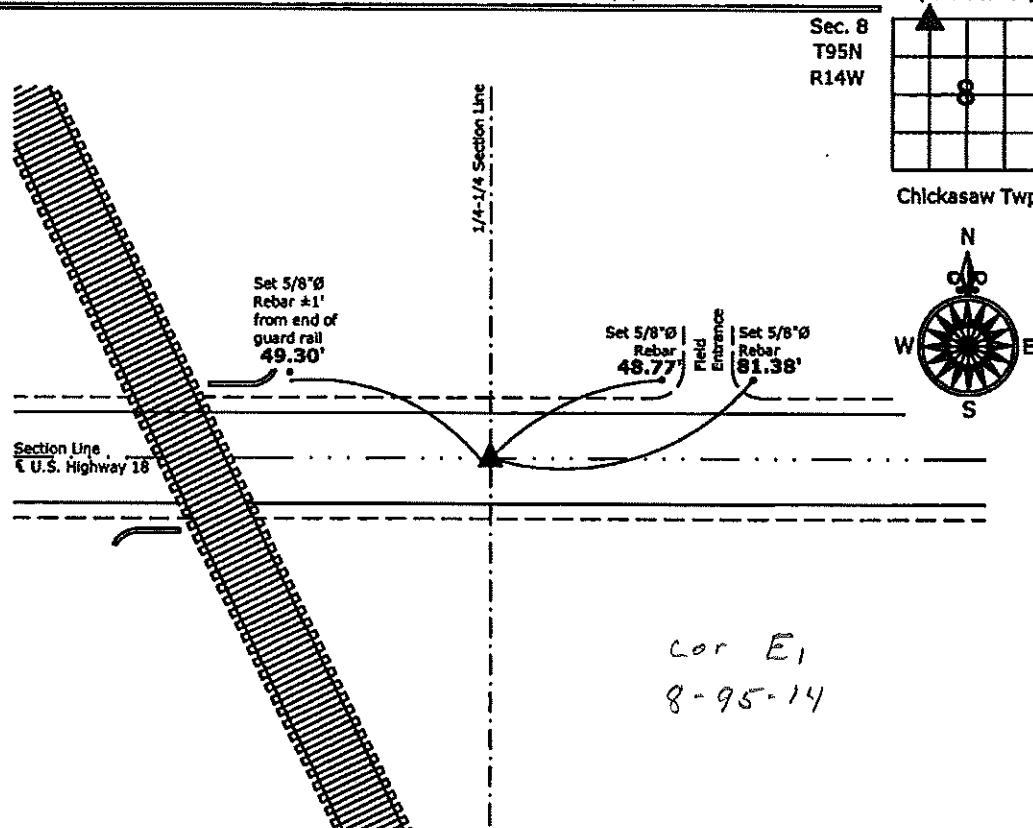

Northeast Corner NW 1/4-NW 1/4 Section 8-95-14
 Cut "X" in PCC Pavement



I hereby certify that this land surveying document was prepared and the related survey work was performed by me or under my direct personal supervision and that I am a duly licensed Land Surveyor under the laws of the State of Iowa.

Kirk D. Reicks 1-12-12
 Kirk D. Reicks
 Date:

License number 19211

My license renewal date is December 31, 2012.
 Sheets covered by this seal: Individual sheet only

List Corners to be Indexed			
Corners	Section	Twp.	Range
NE-NW-NW	8	95	14

Project Number: 2011-129

FB: Chickasaw County 3, Pgs. 74-75

02061 | FILED FOR RECORD THE..... 6th DAY OF STATE OF IOWA, CHICKASAW COUNTY,
 DOCUMENT NO. RECORDING FEE \$ 6.00 May 19, 96. AT 11:27 RECORDER *Leitha N. Ross*
 RECORDING FEE \$ 6.00 TRANSFER FEE \$ o'clock A.M. BOOK 160 Deed PAGE 443 DEPUTY *Leitha N. Ross*
 By Deputy

Prepared by: Erdman Engineering P.C. 708 Commerce Drive, P.O. Box 246, Decorah Iowa, 52101
 Phone (319)382-4194, Fax (319)382-3623

United States Public Land Survey Corner Certificate
 of



Land Survey Monuments situated in Section, 5 Township, 95 Range, 12 of the Fifth Principle Meridian,
Chickasaw County, Iowa. Previously recorded in does not apply in County Recorders Office.

(Show reason for preparing this certificate, the evidence and detailed procedures used in establishing the
 corner positions and monumentation found or placed.)

Monument Description and Remarks: This certificate is prepared in accordance with Section 355.11
 of the 1995 Code of Iowa. No previous certificate has been filed for this corner location. We set
 a 1/2" bar with cap RLS #11442 at the existing fence corner as the SSW 1/8 corner of Sec. 5-95-12.
 Property line fences from this corner run North, East and West. A distance from the SW Corner to the
 SSW 1/8 Corner of 20.34 chains was found in the County Engineer's tie records and we checked this
 distance with a distance between the SW corner and fence found at the SSW 1/8 Corner.

Plan-View
 (Show a minimum of three reference ties to durable physical objects, relevant
 monuments and physical conditions that will enable recovery of the corner.)


Nail with cap on East side of wood post.

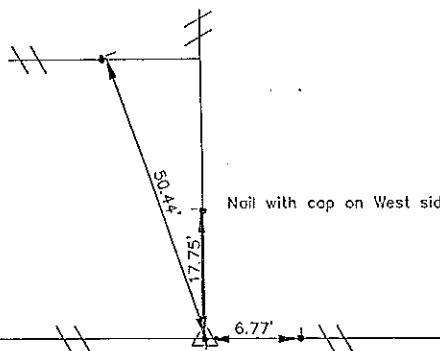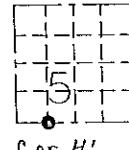

Nail with cap on South side of wood post.

Cor H

SSW 1/8 Corner Set 1/2" bar
 with cap RLS #11442.

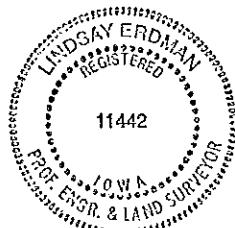

I hereby certify that the survey work was completed
 and this certificate was prepared by me or under my
 direct supervision and that I am a duly registered
 land surveyor under the laws of the State of Iowa.

Signature:

Lindsay Erdman, P.E. and L.S.

Date: 4/2/96 Reg. No. 11442

My license will be renewed January 1, 1997

List Corners to be Indexed
 Corners Section Twp. Range
 SSW 1/8 5 95 12

BOOK 60 PAGE 443

b095015