

XX DOCUMENT NO. <b>02062</b>	FILED FOR RECORD THE <b>6th</b>	DAY OF <b>STATE OF IOWA, CHICKASAW COUNTY,</b>
RECORDING FEE <b>\$ 6.00</b>	May <b>1996</b> AT <b>11:27</b>	RECORDED BY <b>LETTIE N. ROSS</b>
S TRANSFER FEE <b>\$ -----</b>	O'CLOCK A.M. BOOK <b>160</b> Deed PAGE <b>444</b>	Deputy

Prepared by: Erdman Engineering P.C. 708 Commerce Drive, P.O. Box 246, Decorah Iowa, 52101  
Phone (319)382-4194, Fax (319)382-3623

### United States Public Land Survey Corner Certificate of

Land Survey Monuments situated in Section **5** Township **95** Range **12** of the Fifth Principle Meridian, **Chickasaw County, Iowa**. Previously recorded in does not apply in County Recorders Office.


(Show reason for preparing this certificate, the evidence and detailed procedures used in establishing the corner positions and monumentation found or placed.)

Monument Description and Remarks: This certificate is prepared in accordance with Section 355.11 of the 1995 Code of Iowa. No previous certificate has been filed for this corner location. We set a 1/2" bar with cap RLS #11442 at the existing fence corner as the SSE 1/8 corner of Sec. 5-95-12. Property line fences from this corner run North, South, East and West. The distance to the SE corner (Fd. 3/4" Iron Bar) is close to that found in the County Engineer's Random Chaining Notes for the N. line of the E 1/2 of the SE 1/4 (20.5 chains as compared to our field measured distance of 1352.16').

#### Plan-View

(Show a minimum of three reference ties to durable physical objects, relevant monuments and physical conditions that will enable recovery of the corner.)


Nail with cap on W. side of 18" Ash.

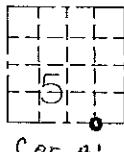

SSE 1/8 Corner Set 1/2" bar  
with cap RLS #11442.



I hereby certify that the survey work was completed and this certificate was prepared by me or under by direct supervision and that I am a duly registered land surveyor under the laws of the State of Iowa.

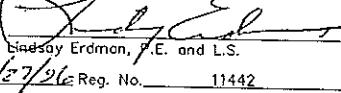Signature:   
Lindsay Erdman, P.E. and L.S.  
Date: 4/27/96 Reg. No. 11442

My license will be renewed January 1, 1997

List Corners to be Indexed			
Corners	Section	Twp.	Range
SSE 1/8	5	95	12

book 60 page 7444