
Section 2-94-13
As referred to in
Engr. Tr. Book

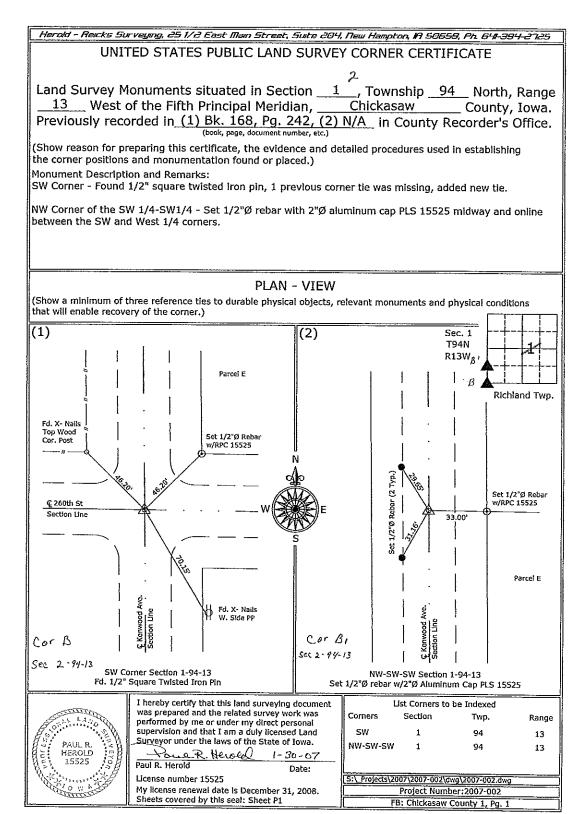

	11 Mes	Heconder Ones Heconder
		ANSFER FEE - \$ O'CLOCK A · M. BOOK 168 Deed PAGE 242 B/ B/ Deputy
	7-94-13 to in Book	UNITED STATES PUBLIC LAND SURVEY CORNER CERTIFICATE
5 ecross	toin	Land Survey Monuments situated in Section, Township, Range
ts resembly	Rock	/3 Wast, of the Fifth Principal Meridian, <u>Chickasaw</u> County, Iowa.
, ng/ (1)	Comment	Previously recorded in in County Recorder's Office.
		(book, page, document number, etc.) (Show reason for preparing this certificate, the evidence and detailed procedures used in establishing the corner position and monumentation found or placed.) Monument Description and Remarks: Found 1e" fwisted iron pin at
		canter of road intersactions
		PLAN – VIEW (Show a minimum of three reference ties to durable physical objects, relevant monuments and physical conditions that we enable recovery of the corner)
		46.10' NW to 8 PIN NE
		Ho, 10' NW to "X" nails wood corner post W 47.40' NE to cantar at top of Steel fence post.
		② 2.50 ^{±5}
		70.15' SE to "X" nails in power pole
		cor B
		2-94-13
		, and the second se
		I hereby certify that the survey work was completed and this land surveying document was prepared by me or under my direct personal supervision and that I am a duly licensed land surveyor under the laws of
		am a duly licensed land surveyor under the laws of the state of lowa
		Signature: Steve Busse Name typed or printed STEVE BUSSE

Date: 7/18/98 Reg. No. 9018

My license renewal date is December 31, 1998

SEAL

1001/68 PAGE 242

Section 2-94-13 As referred to in Engl. The Book

UNITED STATES PUBLIC LAND SURVEY CORNER CERTIFICATE

	OF	-			
Land Survey Monuments situated in Ser Range 13W, of the Fifth Pri	ction 1	l diam	Township _	94N	
country, rowa. Previously recorded in	ncipal mer n <u>does n</u>	ot apply	CHICKASAW		in
County Recorders Office.			document number,		_
(Show reason for preparing this certificate establishing the corner positions and monume	e, the evidentation four	ence and dad	etailed prod ed.)	cedures use	d in
Monument Description and Remarks:	see below				
	·				
		*	***	· · · · · · · · · · · · · · · · · · ·	
	<u> </u>				
					
PI.AI	N ~ VIEW				
(Show a minimum of three reference ties to physical conditions that will enable recover	dusable - L.	sical objec	cts, relevan	t monuments	and
N/4 Cor. Fd. 12" bor 2" down	A or cue co	rner.)		Car A Sec 2	Cor
	dow	or. F.d.	2 00r	. -	7
	1				+-
				7	
Fd. 12 bor in ROW. Fce. Co Tie					
//				•	
Fd. 1/2 bor	e.	1			Λ
. 19.	*	1 to 1	3		Ų
		₹			
	- ENY	o ke			l Ni
	Voils		1 For 12	bac	N
[5] HA.	Cor Post	56.60	Co. Tie		
<u> </u>			Q260ths	<u>`*</u>	
<i>γ</i>		19			\wedge
Cor A World Whoo	·	1 1/2	11		
cor A Wall whoo		8,	Fy"X",	Nalls W.	, M
			cor &		
		ł	2-94-		
! hereby certify that the survey work was completed and this	-	List Corners (
certificate was prepared by me or under by direct personal supervision and that I am a duly registered land surveyor under the have of the state of lowa.	Corners	Section	Twp.	Range.	
Signature:	1.14	//	94	13	
Lindsay Erdnan P.E. & L.S.	N.E.	//	94	/3	
Date: 12-6-94 Reg. No. 11442					
Hy license will be renewed					
SEAL SEAL SEAL SEAL SEAL SEAL SEAL SEAL					
A COUNTRY OF COLOR PROPERTY AND THE					
11442					
A CONTRACTOR OF THE STATE OF TH					
A LAND SHALL	2				
-atolitin-					
	<u></u>				
			94114		
01168	. 0	#	94/60 Ne.	il Kohn	
DOCUMENT NS. U1168 FILED FOR RECORD THE.	70 95 0	DAY OF STATE OF	IOWA, CHICKASAW CO	ימאואי	
S TRANSFER FEE . \$ O'CLOO A.M. BOOK / 50 &	leed 12 46	- X	eithan. C	. xO55	Recorder
н у т	inde/.92	Еу		••	. Deputy