

Chickasaw Co. Recorder
Cindy Messersmith
Fee Book 2017-0018
01/04/2017 @0919AM
SCC SEC COR CERT
Book: Page: \$7.00 # Pages: 1
Total Fees: \$7.00

Prepared by & Return to: Reicks Surveying, 10 East Main Street, New Hampton, IA 50659, Ph. 644-3544-2725

United States Public Land Survey Corner Certificate

Land Survey Monument situated in
Section 13, Township 94 North, Range 13 West of the Fifth Principal Meridian, Chickasaw County, Iowa.
Not on file in the County Recorder's office.

This certificate is being prepared in compliance
with Iowa Code Chapter 355.11 because:


- There is no certificate on file for this corner.
- There are no longer three valid ties of record.
- There are changes to reference ties of record.
- There is change of monumentation of record.
- To clarify description of record monument (ties).

Monument Description and Remarks:


North 1/4 Corner: Found Survey Mark Nail w/Stainless Steel Washer "IDOT" with information obtained from IDOT
Highway As-built construction plans.

Plan View

(Show a minimum of three reference ties to durable physical objects, relevant monuments and physical conditions that will enable recovery of the corner.)

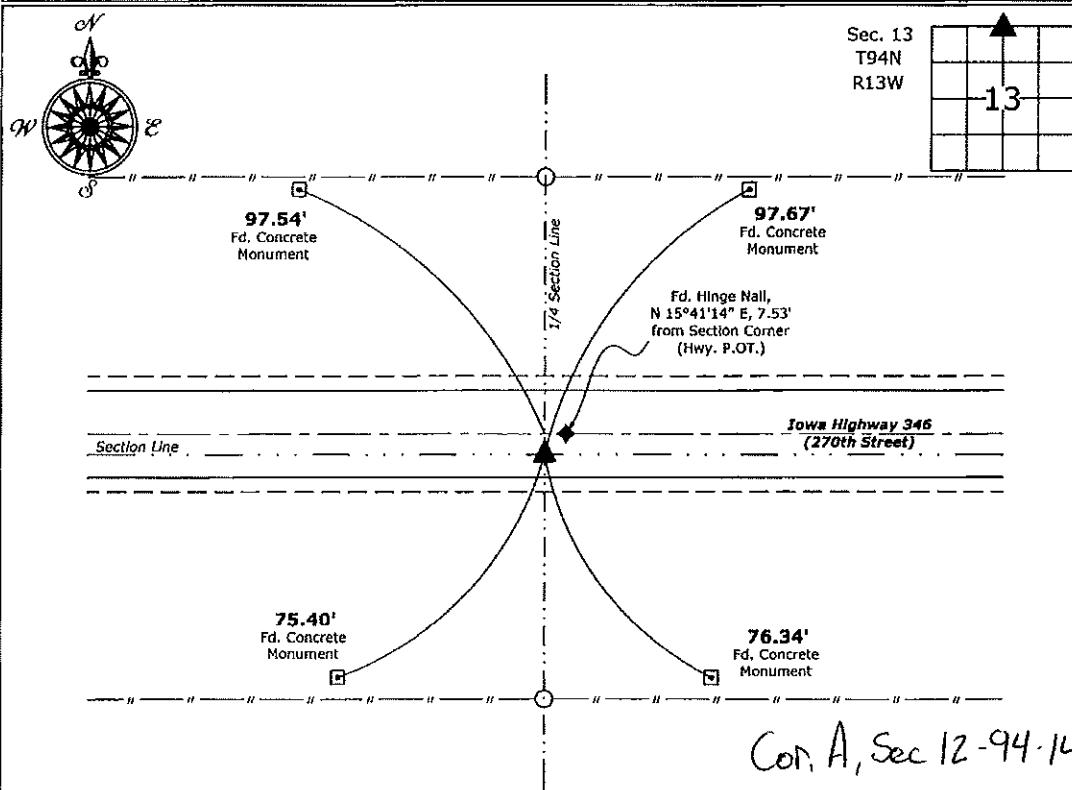

North 1/4 Corner of Section 13-94-13
Found Survey Mark Nail w/Stainless Steel Washer IDOT

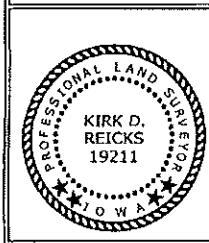

I hereby certify that this land surveying document
was prepared and the related survey work was
performed by me or under my direct personal
supervision and that I am a duly licensed Land
Surveyor under the laws of the State of Iowa.

Kirk D. Reicks 1-2-17

Kirk D. Reicks
Date:
License number 19211
My license renewal date is December 31, 2018.
Sheets covered by this seal: Individual sheet only

List Corner to be Indexed

Corner	Section	Twp.	Range
N 1/4	13	94	13

Project Number: 2016-148
FB: Chickasaw Co. 8, Pgs. 17-18