

Section 14-94-13  
 As referred to in  
 Engr. Tie Book

X  
 I DOCUMENT No. 02021 FILED FOR RECORD THE 1st DAY OF STATE OF IOWA, CHICKASAW COUNTY,  
 C RECORDING FEE \$ 6.00 May 19 96 AT 9:16  
 H TRANSFER FEE \$ 00:00 O'CLOCK A.M. BOOK 60 Deeds PAGE 421  
 S  
 Recorder  
 Deputy

Prepared by: Erdman Engineering P.C. 708 Commerce Drive, P.O. Box 246, Decorah Iowa, 52101  
 Phone (319)382-4194, Fax (319)382-3623


United States Public Land Survey Corner Certificate  
 14 of

Land Survey Monuments situated in Section 13 Township 94 Range 13 of the Fifth Principle Meridian,  
 Chickasaw County, Iowa. Previously recorded in does not apply in County Recorders Office.


(Show reason for preparing this certificate, the evidence and detailed procedures used in establishing the  
 corner positions and monumentation found or placed.)

Monument Description and Remarks: This certificate is prepared in accordance with Section 355.11  
 of the 1995 Code of Iowa. No previous certificate has been filed for this corner location. Based on  
 previous plat Bk.120, p.53 in the Chickasaw County Recorder's Office we found a 5/8" pipe with cap  
 R.L.S. #2886 at the WNW 1/8 corner of Section 13-94-13.

Plan-View  
 (Show a minimum of three reference ties to durable physical objects, relevant  
 monuments and physical conditions that will enable recovery of the corner.)

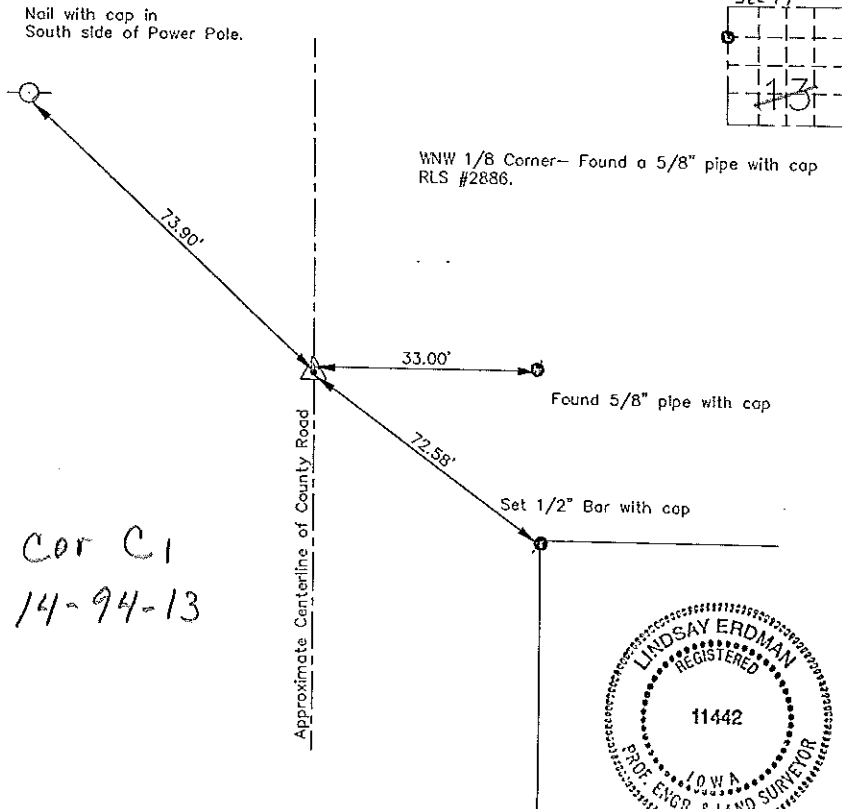

Cor C1  
 14-94-13

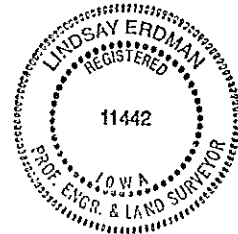

I hereby certify that the survey work was completed  
 and this certificate was prepared by me or under by  
 direct supervision and that I am a duly registered  
 land surveyor under the laws of the State of Iowa.  
 Signature: Lindsay Erdman  
 Lindsay Erdman, P.E. and L.S.  
 Date: 3/18/96 Reg. No. 11442  
 My license will be renewed January 1, 1997

Corners	List Corners to be Indexed		
	Section	Twp.	Range
WNW 1/8	13	94	13