

Chickasaw Co. Recorder
 Cindy Messersmith
Fee Book 2009-0255
 02/03/2009 @10:37AM
 SCC SEC COR CERT
 Book: Page: # Pages: 1
 Total Fees: \$7.00

Section 11-94-13
 As referred to in
 Engr Title Book

Herold - Recks Surveying, 25 1/2 East Main Street, Suite 204, New Hampton, IA 50659, Ph. 641-394-2725

UNITED STATES PUBLIC LAND SURVEY CORNER CERTIFICATE

Land Survey Monuments situated in Section 14, Township 94 North, Range 13 West of the Fifth Principal Meridian, Chickasaw County, Iowa. 1.) Previously recorded as Doc. #2007-2074 in the County Recorder's office. 2.) Not previously recorded in the County Recorders office.

This certificate is being prepared in compliance with Iowa Code Chapter 355.11 because:


- 2. There is no certificate on file for this corner.
- There are no longer three valid ties of record.
- There are changes to reference ties of record.
- 1. There is change of monumentation of record.
- To clarify description of record monument (ties).

Monument Description and Remarks:

- 1.) **North 1/4 Corner Section 14-94-13:** Set MAG nail w/stainless steel washer PLS 15525, 8.54' South of the Centerline of Iowa Hwy. 346, from previously obtained coordinates. Monument set after an HMA overlay.
- 2.) **NE Corner Section 14-94-13:** Set MAG nail w/stainless steel washer PLS 15525, from previously obtained coordinates. Monument set after an HMA overlay.

PLAN - VIEW

(Show a minimum of three reference ties to durable physical objects, relevant monuments and physical conditions that will enable recovery of the corner.)

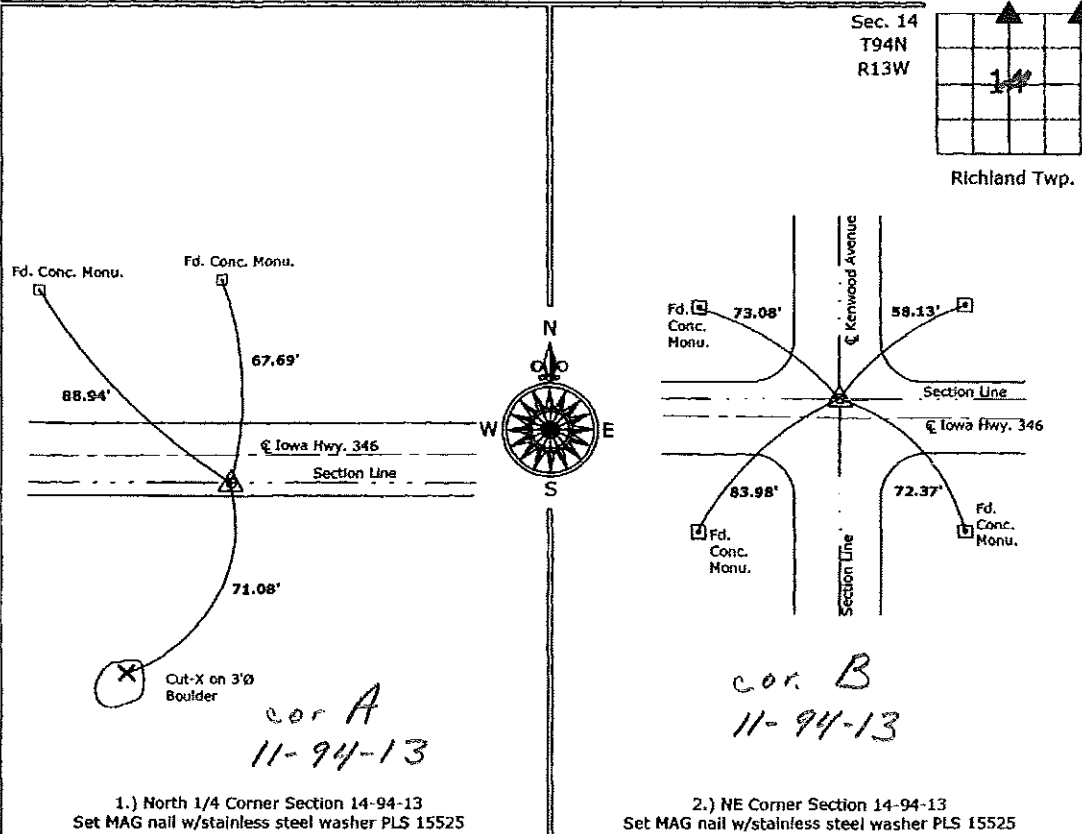

I hereby certify that this land surveying document was prepared and the related survey work was performed by me or under my direct personal supervision and that I am a duly licensed Land Surveyor under the laws of the State of Iowa.

Paul R. Herold 1-28-09
 Paul R. Herold Date:
 License number 15525
 My license renewal date is December 31, 2010.
 Sheets covered by this seal: Individual sheet only

List Corners to be Indexed			
Corners	Section	Twp.	Range
N1/4	14	94	13
NE	14	94	13

Project Number: 2009-003
 FB: Chickasaw County 1, Pg. 18

File: S:\Projects\2009\2009-003\img\2009-003.dwg, 1/28/2009 3:35:13 PM