

*Herold - Reicks Surveying, 10 East Main Street, New Hampton, IA 50659, Ph. 641-394-2725, Fax. 641-394-2710*

**UNITED STATES PUBLIC LAND SURVEY CORNER CERTIFICATE**

18

Land Survey Monuments situated in Section 19, Township 94 North, Range 13 West of the Fifth Principal Meridian, Chickasaw County, Iowa. 1.) & 2.) Not previously recorded in the County Recorder's office.

This certificate is being prepared in compliance with Iowa Code Chapter 355.11 because:

- 1.) & 2.)  There are no certificates on file for these corners.
- There are no longer three valid ties of record.
- There are changes to reference ties of record.
- There is change of monumentation of record.
- To clarify description of record monument (ties).



Monument Description and Remarks:

1.) **North 1/4 Corner:** Found 1/2"Ø rebar with 1.5"Ø aluminum cap PLS 2175 with information obtained from the County Engineer's office.

2.) **East 1/4 Corner:** Found 1"Ø pipe with information obtained from a Survey and Plat made by Robert L. Haylock, recorded in Book Deeds 149, Pg. 279, on file in the Chickasaw County Recorder's office, New Hampton, IA.

**PLAN - VIEW**

(Show a minimum of three reference ties to durable physical objects, relevant monuments and physical conditions that will enable recovery of the corner.)

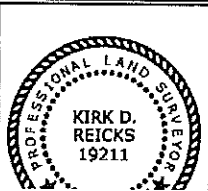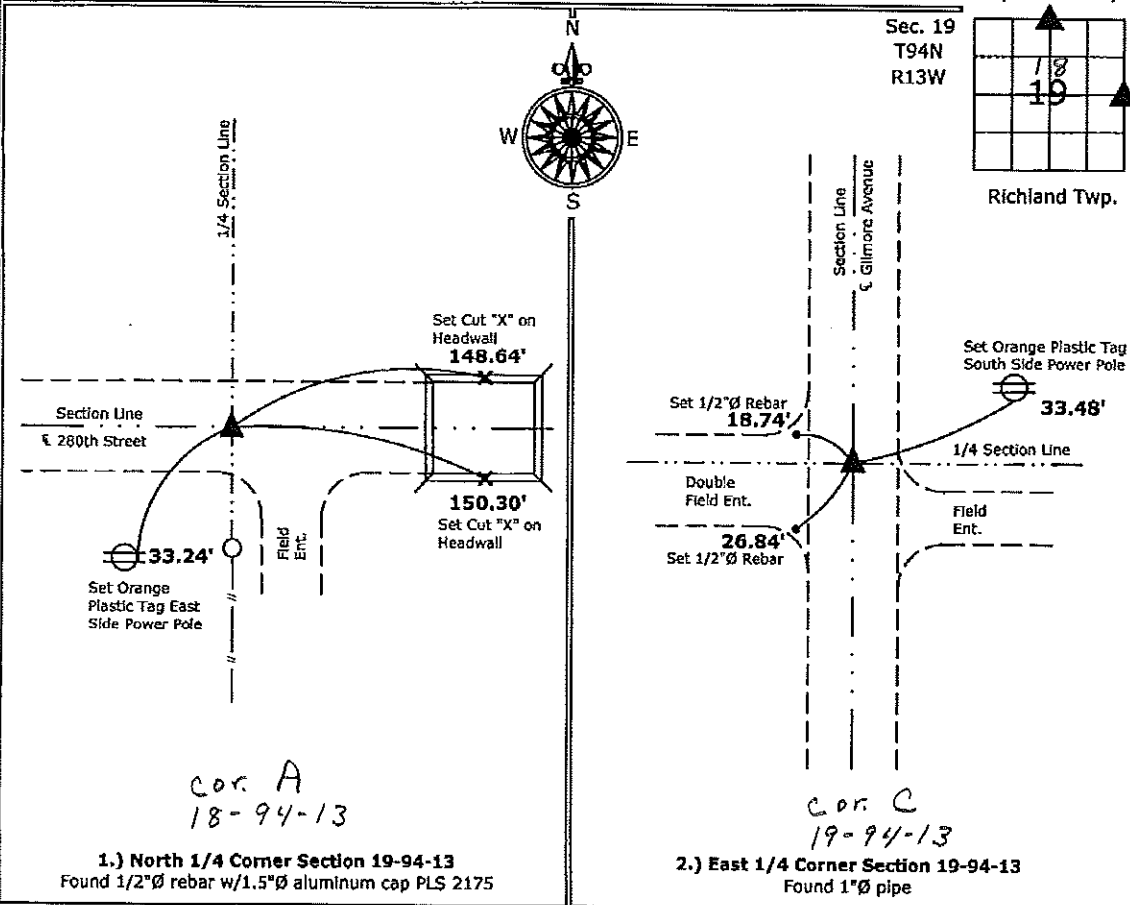

I hereby certify that this land surveying document was prepared and the related survey work was performed by me or under my direct personal supervision and that I am a duly licensed Land Surveyor under the laws of the State of Iowa.

*Kirk D. Reicks* 10-5-10  
 Kirk D. Reicks Date:

List Corners to be Indexed			
Corners	Section	Twp.	Range
N 1/4	19	94	13
E 1/4	19	94	13

Projects\2010\2010-132\dwg\2010-132.dwg, 10/5/2010 5:40:23 PM