

Prepared by & Return to: Herold - Reicks Surveying, 10 East Main Street, New Hampton, IA 50659, Ph. 641-394-2725

### United States Public Land Survey Corner Certificate

Land Survey Monument situated in  
 Section 27, Township 94 North, Range 13 West of the Fifth Principal Meridian, Chickasaw County, Iowa.  
 Not on file in the County Recorder's office.

This certificate is being prepared in compliance with Iowa Code Chapter 355.11 because:


- There is no certificate on file for this corner.
- There are no longer three valid ties of record.
- There are changes to reference ties of record.
- There is change of monumentation of record.
- To clarify description of record monument (ties).

**Monument Description and Remarks:**

**East 1/4 Corner:** Found 9"x9" Granite Stone matching possession evidence in the section. This position only accepted after comparing distances to adjacent corners and possession lines in said Section. Placed Cut "X" in stone and set 5/8"Ø rebar w/2"Ø aluminum cap PLS 15525 0.40' North of stone.  
 Corner was accepted as true based on lines of ownership, and the characteristics of the monument match those of common monuments recovered in Chickasaw County.

**Plan View**

(Show a minimum of three reference ties to durable physical objects, relevant monuments and physical conditions that will enable recovery of the corner.)

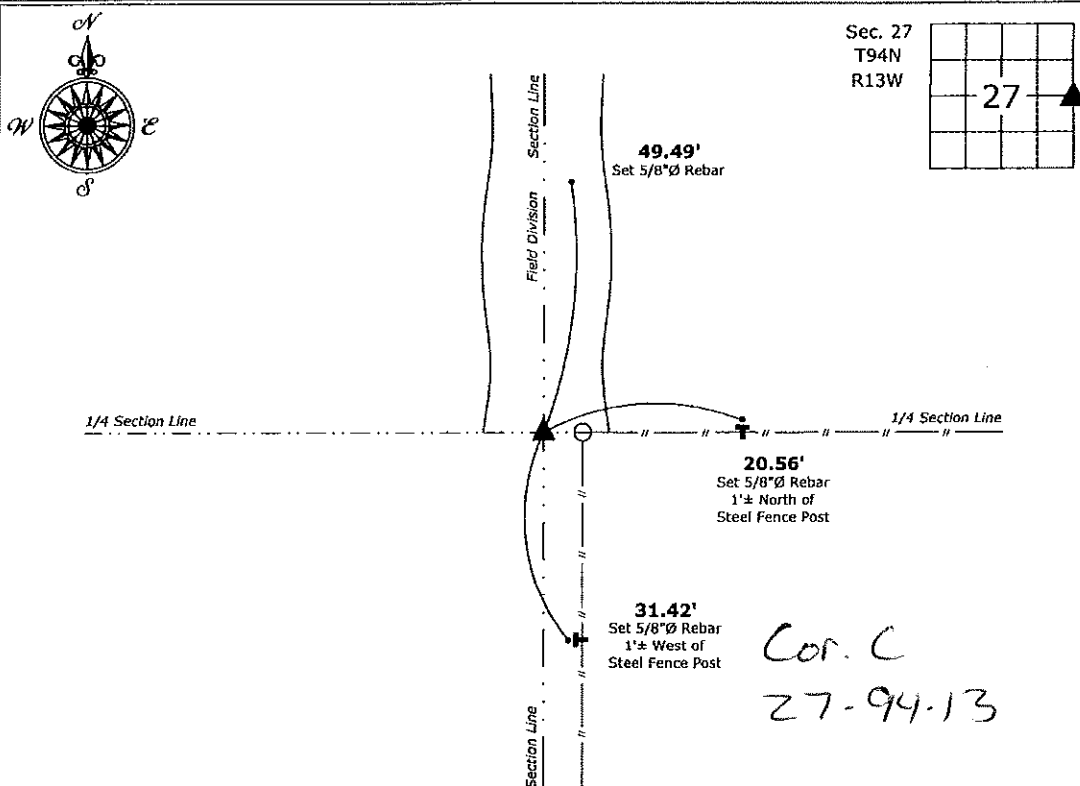

**East 1/4 Corner of Section 27-94-13**  
 Found 9"x9" granite stone, set 5/8"Ø rebar w/2"Ø aluminum cap PLS15525  
 0.40' North of stone



I hereby certify that this land surveying document was prepared and the related survey work was performed by me or under my direct personal supervision and that I am a duly licensed Land Surveyor under the laws of the State of Iowa.

*Paul R. Herold* 1-26-18  
 Paul R. Herold Date:  
 License number 15525  
 My license renewal date is December 31, 2018.  
 Sheets covered by this seal: Individual sheet only

List Corner to be Indexed			
Corner	Section	Twp.	Range
E 1/4	27	94	13
Project Number: 2017-144			
FB: Chickasaw County B, Pgs. 51-52			