

TeKIPPE ENGINEERING, P.C., 128 South Vine Street, West Union, Iowa 52175 Phone (563) 422-5131

**UNITED STATES PUBLIC LAND SURVEY CORNER CERTIFICATE**  
 OF

Land Survey Monuments situated in Section 22, Township 94 North, Range 13 West of the Fifth Principal Meridian, Chickasaw County, Iowa.  
 Previously recorded in (1) none (2) none in County Recorder's Office.  
 (book, page, document number, etc.)

(Show reason for preparing this certificate, the evidence and detailed procedures used in establishing the corner positions and monumentation found or placed.)


Monument Description and Remarks: (1) S1/4 Corner of Section 22-T94N-R13W:  
 Found 3/4"Ø iron pin with information obtained from County Engineer's office.

(2) SE Corner of Section 22-T94N-R13W:  
 Found 1/2" square iron pin with information obtained from County Engineer's office.

**PLAN VIEW**

Project Number 121081.LS  
 Field Book: 46M, Page 77

Show a minimum of three reference ties to durable physical objects, relevant monuments and physical conditions that will enable recovery of the corner.

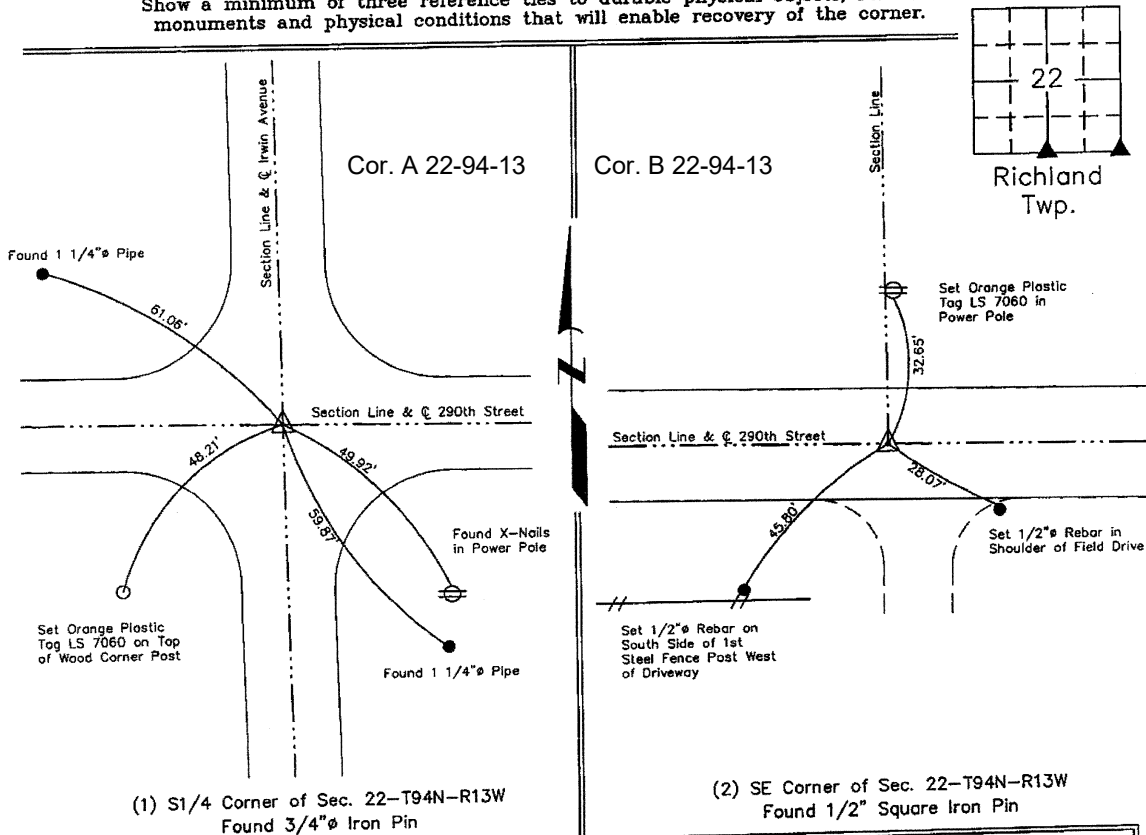

(1) S1/4 Corner of Sec. 22-T94N-R13W  
 Found 3/4"Ø Iron Pin

(2) SE Corner of Sec. 22-T94N-R13W  
 Found 1/2" Square Iron Pin

	I hereby certify that this land surveying document was prepared and the related survey work was performed by me or under my direct personal supervision and that I am a duly licensed Land Surveyor under the laws of the State of Iowa.	<b>List Corners to be Indexed</b>											
	Lyle G. TeKippe, P.E. & P.L.S. License Number 7060 My license renewal date is December 31, 2012. Sheets covered by this seal: This Sheet Only	<table border="1"> <thead> <tr> <th>Corners</th> <th>Section</th> <th>Twp.</th> <th>Range</th> </tr> </thead> <tbody> <tr> <td>S1/4</td> <td>22</td> <td>94N</td> <td>13W</td> </tr> <tr> <td>SE</td> <td>22</td> <td>94N</td> <td>13W</td> </tr> </tbody> </table>	Corners	Section	Twp.	Range	S1/4	22	94N	13W	SE	22	94N
Corners	Section	Twp.	Range										
S1/4	22	94N	13W										
SE	22	94N	13W										

X:\Section Corners\Sec. 22\22-94-13WY.dwg