

000001 000002 000003 000004 000005 000006 000007 000008 000009 000010

United States Public Land Survey Corner Certificate

Land Survey Monument situated in
Section **32**, Township **94** North, Range **13** West of the Fifth Principal Meridian, **Chickasaw** County, Iowa.
Not on file in the County Recorder's Office.

This certificate is being prepared in compliance with Iowa Code Chapter 355.11 because:

- ☒ There is no certificate on file for this corner.
☐ There are no longer three valid ties of record.
☐ There are changes to reference ties of record.
☐ There is change of monumentation of record.
☐ To clarify description of record monument (ties).



Monument Description and Remarks:

Northwest Corner:

Found 5/8"Ø Iron Pin with information obtained from the Chickasaw County Engineer's Office, in Field Book Richland Township Ties to Corners, Section 30, Corner B.

Plan View - Not to Scale

(Show a minimum of three reference ties to durable physical objects, relevant monuments and physical conditions that will enable recovery of the corner.)

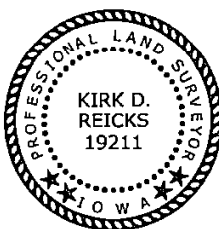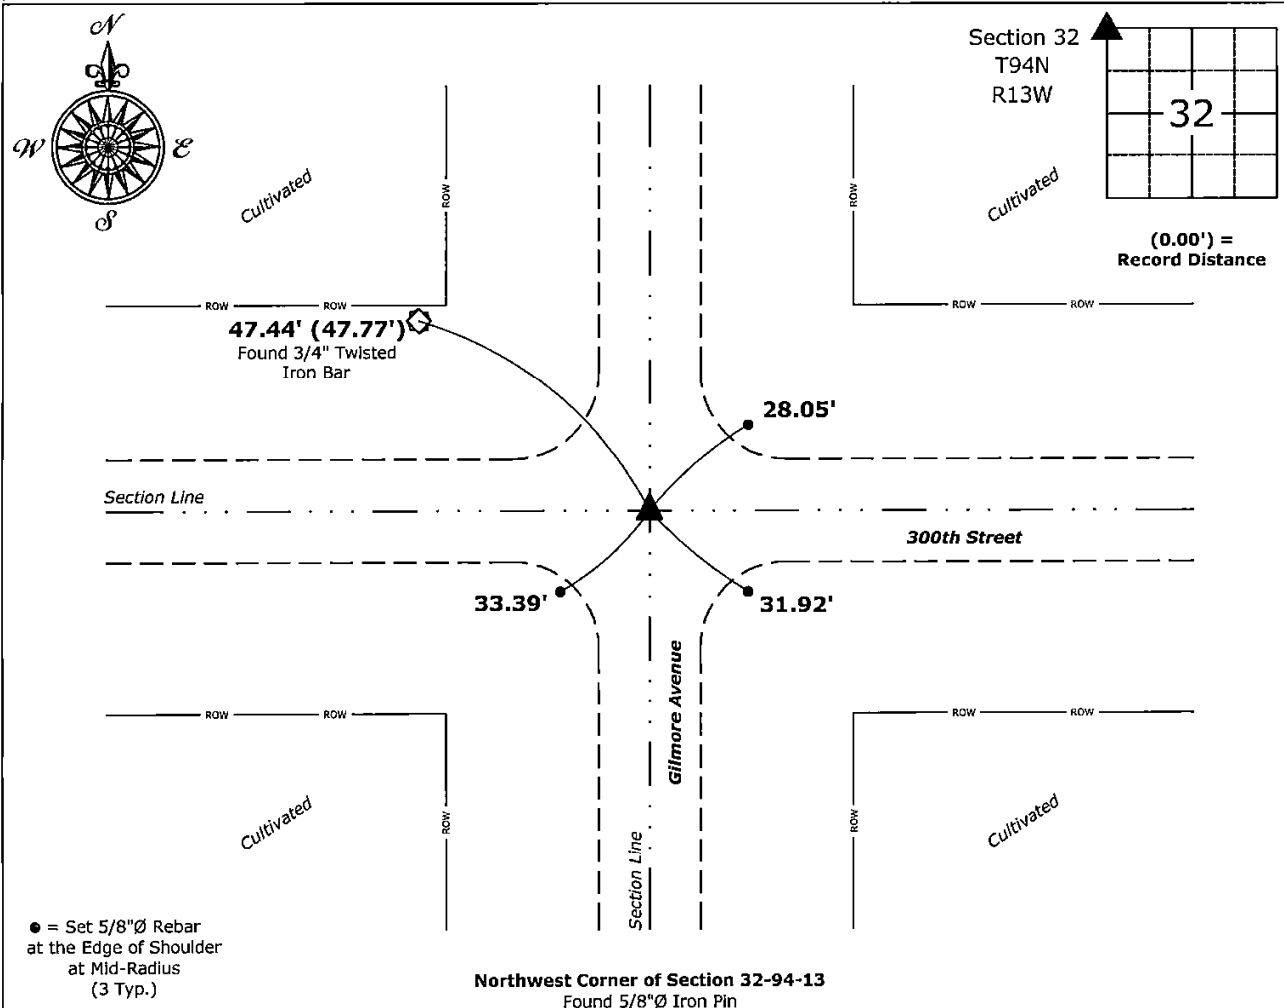

I hereby certify that this land surveying document was prepared and the related survey work was performed by me or under my direct personal supervision and that I am a duly licensed Land Surveyor under the laws of the State of Iowa.

Kirk D. Reicks 5-13-2026
Kirk D. Reicks Date:

License Number 19211

My License Renewal Date is December 31, 2026.
Sheets covered by this seal: Individual sheet only

List Corner to be Indexed

Corner	Section	Township	Range
NW	32	94	13

Project Number: 2026-043

FB: Chickasaw 13, Page(s) 71-72

File: S:_Projects - NHO\County Control Systems\CHICKASAW\CHICK-47\CHICK-47-2026.dwg, 5/13/2026 6:59:39 AM