

000000

United States Public Land Survey Corner Certificate

Land Survey Monument situated in
Section **32**, Township **94** North, Range **13** West of the Fifth Principal Meridian, **Chickasaw** County, Iowa.
On file in **Book 159, Page 254** in the County Recorder's Office.

This certificate is being prepared in compliance with Iowa Code Chapter 355.11 because:

- ☐ There is no certificate on file for this corner.
☒ There are no longer three valid ties of record.
☐ There are changes to reference ties of record.
☐ There is change of monumentation of record.
☐ To clarify description of record monument (ties).



Monument Description and Remarks:

Northeast Corner:

Found PK Nail with information obtained from the previously recorded Section Corner Certificate.

Plan View - Not to Scale

(Show a minimum of three reference ties to durable physical objects, relevant monuments and physical conditions that will enable recovery of the corner.)

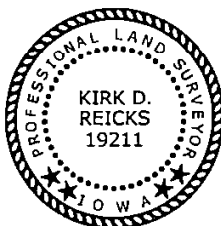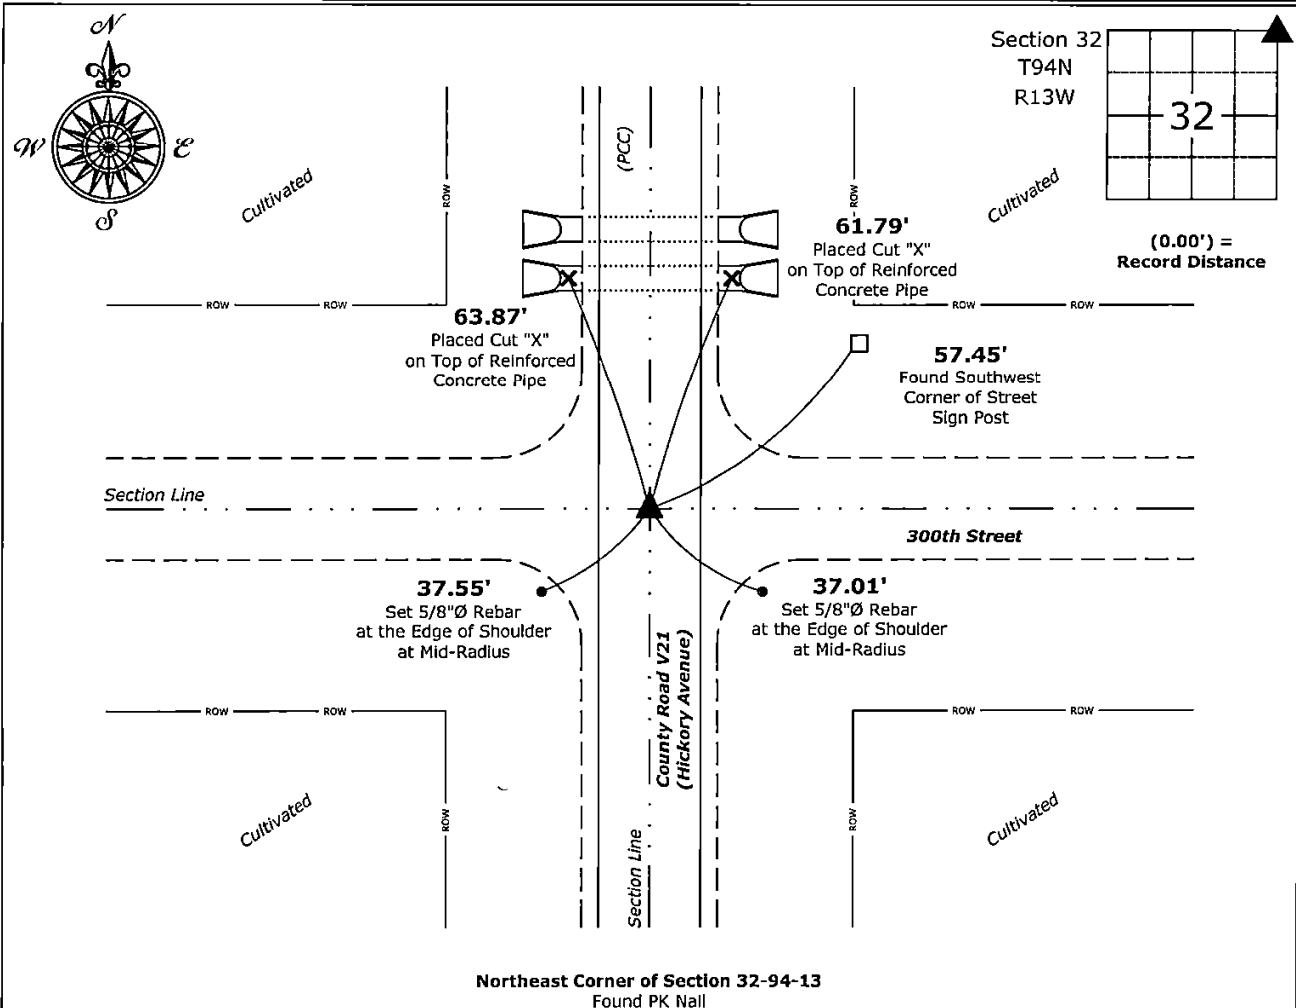

I hereby certify that this land surveying document was prepared and the related survey work was performed by me or under my direct personal supervision and that I am a duly licensed Land Surveyor under the laws of the State of Iowa.

Surveyor under the laws of the State of Iowa
Kurt D. Reed 5-13-2026

Kirk D. Reicks

Date:

License Number 19211

My License Renewal Date is December 31, 2026.

My License Renewal Date is December 31, 2020:
 Sheets covered by this seal: Individual sheet only

List Corner to be Indexed

Corner	Section	Township	Range
NE	32	94	13

Project Number: 2026-043

FB: Chickasaw 13, Page(s) 71-72