

Section 28-94-13  
 As referred to in  
 Engr Tie Book

SLS1 9-94

UNITED STATES PUBLIC LAND SURVEY CORNER CERTIFICATE


OF  
 28  
 Land Survey Monuments situated in Section 33, Township 94 North, Range 13 West, of the Fifth Principal Meridian, Chickasaw County, Iowa.  
 Previously recorded in N/A in County Recorder's Office.  
(book, page, document number, etc.)

(Show reason for preparing this certificate, the evidence and detailed procedures used in establishing the corner positions and monumentation found or placed.)

Monument Description and Remarks: Found a PK nail in centerline of County road V21 also called Hickory Ave. Found one remaining tie from County Engineer's records. Set new ties as shown below. Found 3/4" iron pin at north 1/4 cor. Corner is in center of 300th st. Corner is east of drive to farmstead on north side of road. Also falls on east side of grove to 1844 300th st. Set new ties as shown below.

PLAN - VIEW

(Show a minimum of three reference ties to durable physical objects, relevant monuments and physical conditions that will enable recovery of the corner.)

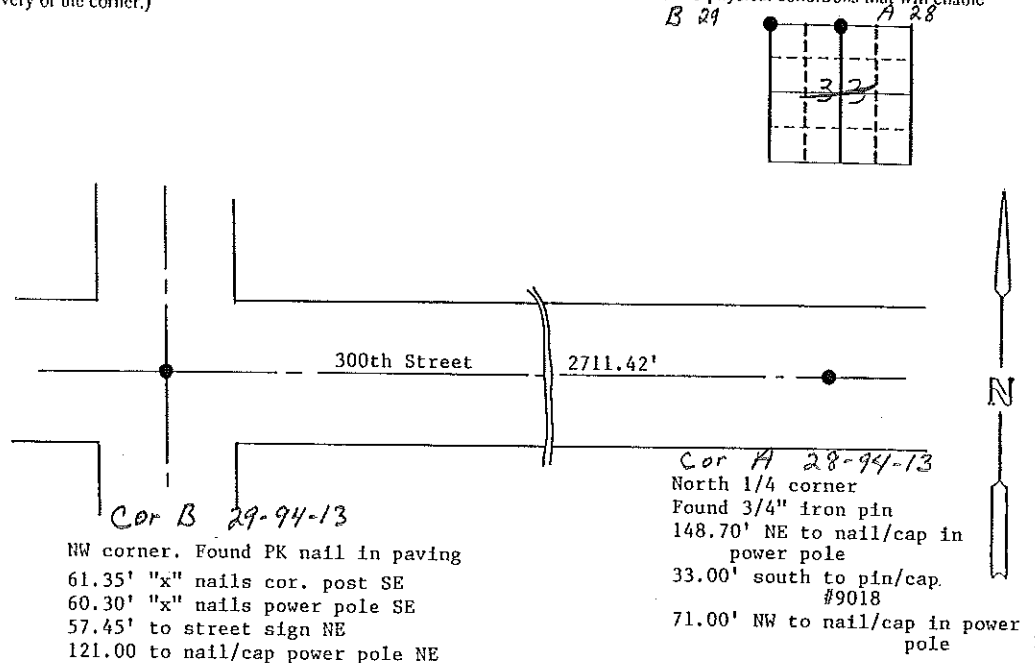

**Cor B 29-94-13**  
 NW corner. Found PK nail in paving  
 61.35' "x" nails cor. post SE  
 60.30' "x" nails power pole SE  
 57.45' to street sign NE  
 121.00 to nail/cap power pole NE

**Cor A 28-94-13**  
 North 1/4 corner  
 Found 3/4" iron pin  
 148.70' NE to nail/cap in power pole  
 33.00' south to pin/cap. #9018  
 71.00' NW to nail/cap in power pole

I hereby certify that the survey work was completed and this land surveying document was prepared by me or under my direct personal supervision and that I am a duly registered land surveyor under the laws of the state of Iowa

Signature: Steve Busse  
 Name typed or printed: STEVE BUSSE

Date: 11/21/95 Reg. No. 9018

My registration renewal date is December 31, 1996

SEAL

Corners	List Section	Index Twp	Range
NW cor	33	94	13
N 1/4 cor.	33	94	13

Place in tie Book  
 11/28/95  
 JFM