

>

Chickasaw Co. Recorder
 Cindy Messersmith
Fee Book 2007-0969
 05/14/2007 @1036AM
 SCC SEC COR CERT
 Book Page: # Pages: 1
 Total Fees: \$7.00

Herald - Reicks Surveying, 25 1/2 East Main Street, Suite 264, New Hampton, IA 50659, Ph. 641-394-2725

UNITED STATES PUBLIC LAND SURVEY CORNER CERTIFICATE

Land Survey Monuments situated in:

Section 2, Township 94 North, Range 13 West of the Fifth Principal Meridian,
 Chickasaw County, Iowa. Previously recorded in 1.} None
2.} None
 in County Recorder's Office.



(Show reason for preparing this certificate, the evidence and detailed procedures used in establishing the corner positions and monumentation found or placed.)

Monument Description and Remarks:

- 1.} SW Corner NW 1/4-NW 1/4 Section 2-94-13, Set 1/2"Ø rebar w/2"Ø aluminum cap PLS 15525 by single proportion between the W 1/4 Corner and the NW Corner.
- 2.} SW Corner SE 1/4-SE 1/4 Section 2-94-13, Set 1/2"Ø rebar w/2"Ø aluminum cap PLS 15525 midway and on line between the S 1/4 Corner and the SE Corner.

PLAN - VIEW

(Show a minimum of three reference ties to durable physical objects, relevant monuments and physical conditions that will enable recovery of the corner.)

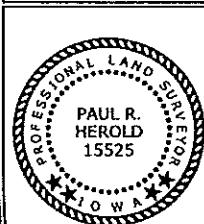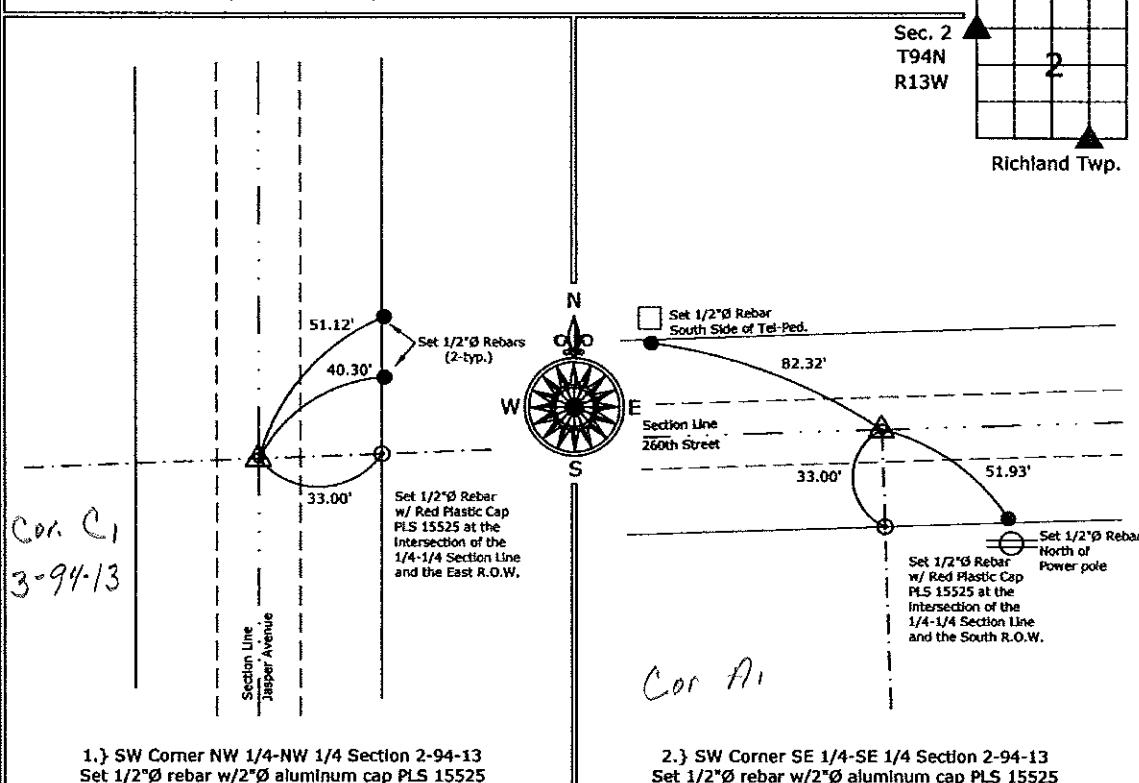

I hereby certify that this land surveying document was prepared and the related survey work was performed by me or under my direct personal supervision and that I am a duly licensed Land Surveyor under the laws of the State of Iowa.

Paul R. Herold *5-12-07*

Paul R. Herold Date:

License number 15525

My license renewal date is December 31, 2008.
 Sheets covered by this seal: Sheet P1

List Corners to be Indexed

Corners	Section	Twp.	Range
SW-NW-NW	2	94	13
SW-SE-SE	2	94	13

Project Number: 2007-033

FB: Chickasaw County 1, Pgs. 13-20