

Prepared by & Return to: Herold - Reicks Surveying, 10 East Main Street, New Hampton, IA 50659, Ph. 641-394-2725

UNITED STATES PUBLIC LAND SURVEY CORNER CERTIFICATE

Land Survey Monuments situated in Section **7**, Township **94** North, Range **13** West of the Fifth Principal Meridian, **Chickasaw** County, Iowa. **1.) & 2.)** Not previously recorded in the County Recorder's office.

This certificate is being prepared in compliance with Iowa Code Chapter 355.11 because:

- 1.) & 2.) There is no certificate on file for this corner.
 There are no longer three valid ties of record.
 There are changes to reference ties of record.
 There is change of monumentation of record.
 To clarify description of record monument (ties).


Monument Description and Remarks:

1.) North 1/4 Corner: Found 5/8"Ø rebar with information obtained from the Chickasaw County Engineer's office in field book "Bradford Twp., Section 6, Corner "A".

2.) West 1/4 Corner: Set 5/8"Ø rebar with 2"Ø aluminum cap PLS 15525 at the intersection of existing property line fences based on the information obtained from the County Engineer's office in Surveyors Book 1, a survey that established the Center of the Section by A.F. Kemman, County Surveyor, signed Sept. 12, 1911.

PLAN - VIEW

(Show a minimum of three reference ties to durable physical objects, relevant monuments and physical conditions that will enable recovery of the corner.)

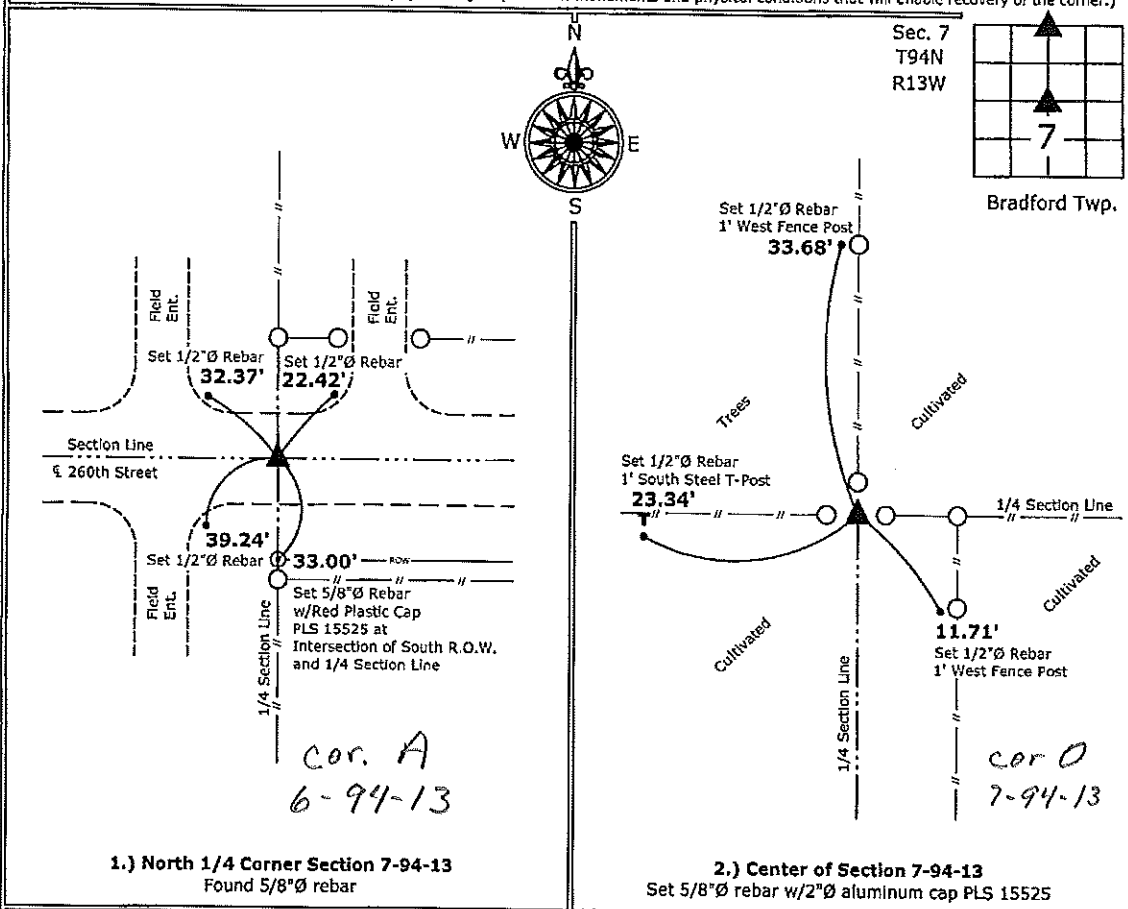

1.) North 1/4 Corner Section 7-94-13
 Found 5/8"Ø rebar

2.) Center of Section 7-94-13
 Set 5/8"Ø rebar w/2"Ø aluminum cap PLS 15525



I hereby certify that this land surveying document was prepared and the related survey work was performed by me or under my direct personal supervision and that I am a duly licensed Land Surveyor under the laws of the State of Iowa.

Paul R. Herold 7-26-11
 Paul R. Herold Date:

License number 15525
 My license renewal date is December 31, 2012.
 Sheets covered by this seal: Individual sheet only

List Corners to be Indexed			
Corners	Section	Twp.	Range
N 1/4	7	94	13
CTR	7	94	13

Project Number: 2011-089

FB: Chickasaw County 4, Pgs. 5-7