

Chickasaw Co. Recorder
 Cindy Messersmith
Fee Book 2011-1248
 07/26/2011 @0932AM
 SCC SEC COR CERT
 Book: Page: # Pages: 1
 Total Fees: \$7.00

Prepared by & Return to: Herald - Recks Surveying, 10 East Main Street, New Hampton, IA 50659, Ph. 641-394-2725

UNITED STATES PUBLIC LAND SURVEY CORNER CERTIFICATE

1/2

Land Survey Monuments situated in Section 7, Township 94 North, Range 13 West of the Fifth Principal Meridian, Chickasaw County, Iowa. 1.) & 2.) Not previously recorded in the County Recorder's office.

This certificate is being prepared in compliance with Iowa Code Chapter 355.11 because:

{ 1.) & 2.) There is no certificate on file for this corner.
 There are no longer three valid ties of record.
 There are changes to reference ties of record.
 There is change of monumentation of record.
 To clarify description of record monument (ties).


Monument Description and Remarks:

1.) **Northwest Corner:** Found 1"Ø gas pipe with information obtained from the Chickasaw County Engineer's office in field book "Bradford Twp., Section 1, Corner "B".

2.) **West 1/4 Corner:** Found 1"Ø gas pipe with information obtained from the Chickasaw County Engineer's office in field book "Bradford Twp., Section 1, Corner "C".


PLAN - VIEW

(Show a minimum of three reference ties to durable physical objects, relevant monuments and physical conditions that will enable recovery of the corner.)

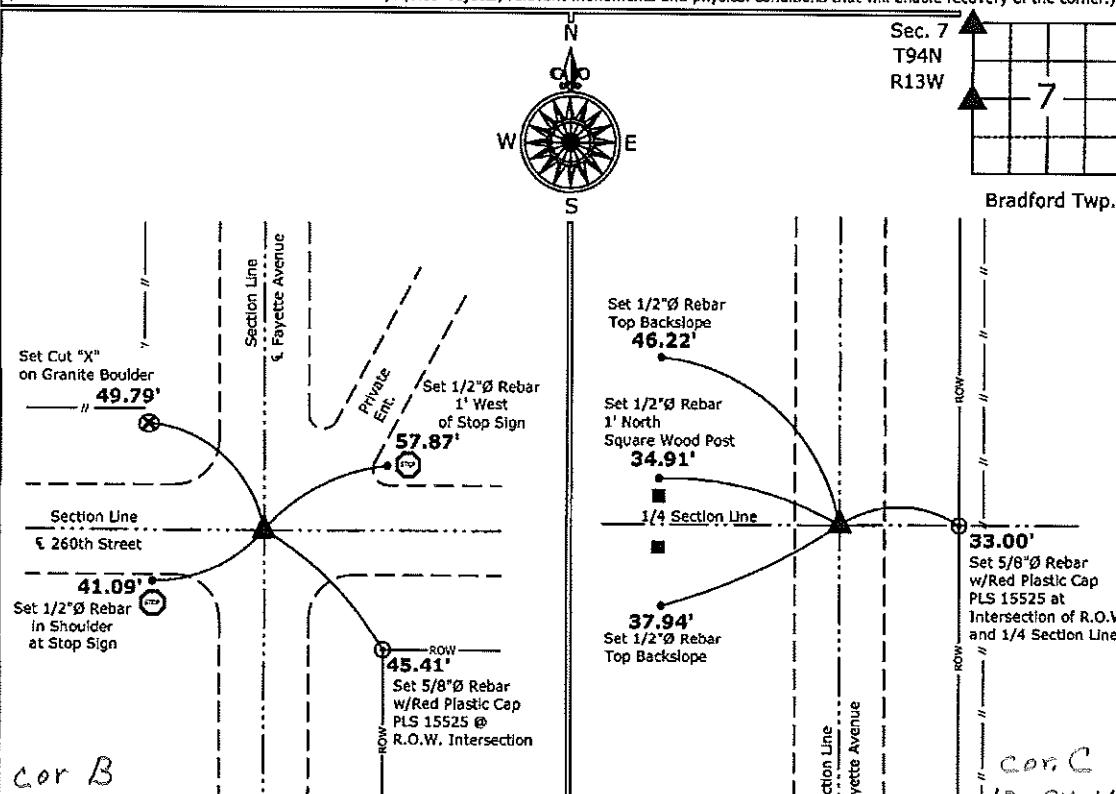

1.) Northwest Corner Section 7-94-13

Found 1"Ø gas pipe

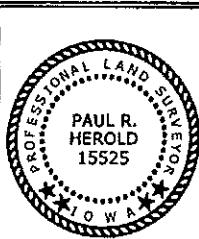

I hereby certify that this land surveying document was prepared and the related survey work was performed by me or under my direct personal supervision and that I am a duly licensed Land Surveyor under the laws of the State of Iowa.

Paul R. Herold 7-26-11

Paul R. Herold

Date:

License number 15525

My license renewal date is December 31, 2012.
 Sheets covered by this seal: Individual sheet only

2.) West 1/4 Corner Section 7-94-13

Found 3/4"Ø gas pipe

List Corners to be Indexed

Corners	Section	Twp.	Range
NW	7	94	13
W 1/4	7	94	13

Project Number: 2011-089

FB: Chickasaw County 4, Pgs. 5-7