

Chickasaw Co. Recorder
 Cindy Messersmith
Fee Book 2008-1846
 09/25/2008 @1140AM
 SCC SEC COR CERT
 Book: Page: # Pages: 1
 Total Fees: \$7.00

Herold - Reicks Surveying, 25 1/2 East Main Street, Suite 204, New Hampton, IA 50659, Ph. 641-394-2725

UNITED STATES PUBLIC LAND SURVEY CORNER CERTIFICATE

Land Survey Monuments situated in Section **12**, Township **95** North, Range **11** West of the Fifth Principal Meridian, **Chickasaw** County, Iowa. Previously not recorded in Chickasaw County Recorder's office.

This certificate is being prepared in compliance with Iowa Code Chapter 355.11 because:


- There is no certificate on file for this corner.
- There are no longer three valid ties of record.
- There are changes to reference ties of record.
- There is change of monumentation of record.
- To clarify description of record monument (ties).

Monument Description and Remarks:

- 1.) NW Corner NE 1/4-SW 1/4- Set 5/8"Ø rebar w/ 2" Aluminum Cap PLS 15525 equidistant and online between W 1/4 and Center of section.
- 2.) Center of Section- Set 5/8"Ø rebar w/ 2" Aluminum Cap PLS 15525 at the intersection of the 1/4 section lines.

PLAN - VIEW

(Show a minimum of three reference ties to durable physical objects, relevant monuments and physical conditions that will enable recovery of the corner.)

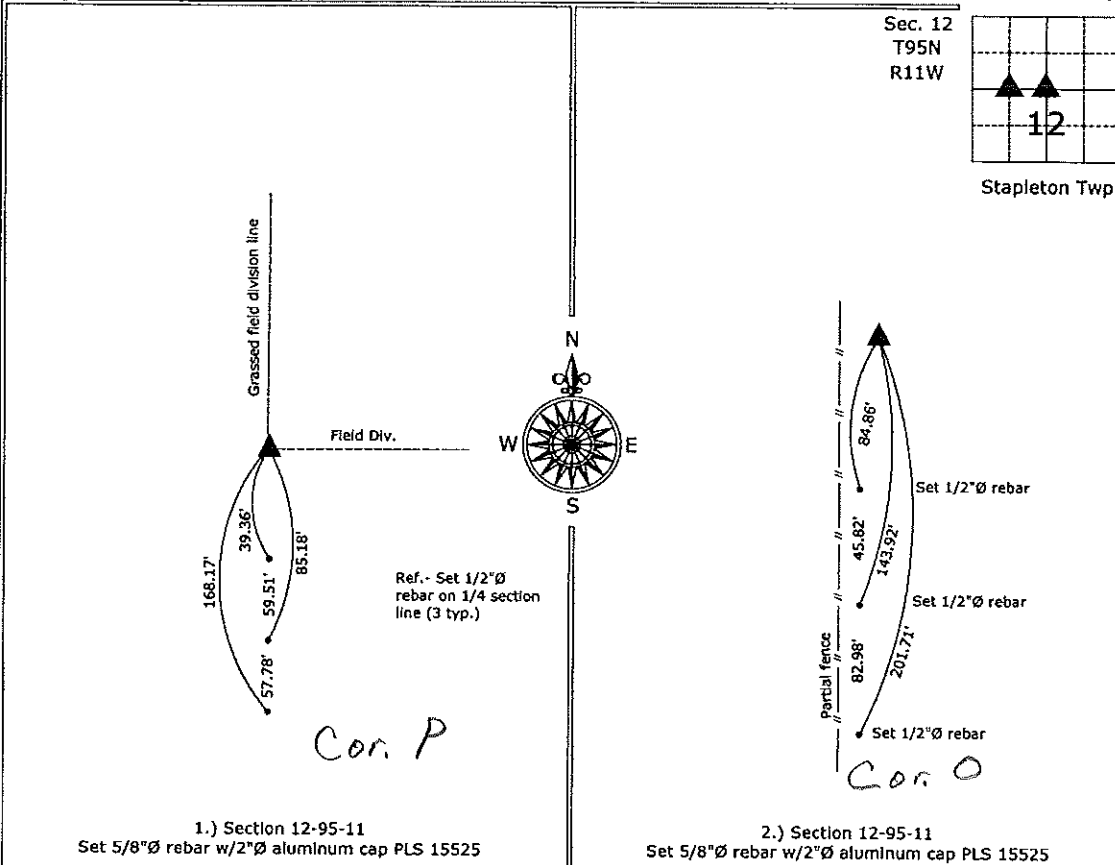

1.) Section 12-95-11
 Set 5/8"Ø rebar w/2"Ø aluminum cap PLS 15525

2.) Section 12-95-11
 Set 5/8"Ø rebar w/2"Ø aluminum cap PLS 15525



I hereby certify that this land surveying document was prepared and the related survey work was performed by me or under my direct personal supervision and that I am a duly licensed Land Surveyor under the laws of the State of Iowa.

Paul R. Herold 9-25-08
 Paul R. Herold Date:
 License number 15525
 My license renewal date is December 31, 2008.
 Sheets covered by this seal: Individual sheet only

List Corners to be Indexed			
Corners	Section	Twp.	Range
NW-NE-SW	12	95	11
Center	12	95	11

Project Number: 2008-099
 FB: Chickasaw County 3, Pgs. 5-6

File: S:\Projects\2008\2008-099.dwg, 9/25/2008 08:37:26