

DOCUMENT No. 02900 FILED FOR RECORD THE 9th DAY OF JUNE 1999 AT 8:53 STATE OF IOWA, CHICKASAW COUNTY.
 RECORDING FEE \$ 6.00 O'CLOCK A M. BOOK 172 PAGE 49 By Cindy Messersmith Recorder
 TRANSFER FEE - \$ _____

Section 1-95-11
 As referred to in
 Engr. TIC Book


Prepared by: Erdman Engineering, P.C. 708 Commerce Drive, P.O. Box 246, Decorah, Iowa 52101
 Phone (319)382-4194, Fax (319)382-3623

United States Public Land Survey Corner Certificate


of
 Land Survey Monuments situated in Section 12 Township 95 Range 11 of the Fifth Principle Meridian,
 Chickasaw County, Iowa. Previously recorded in does not apply in County Recorders Office.

Monument Description and Remarks: This certificate is prepared in accordance with Section 355.11 of the 1995 Code of Iowa. No previous certificate has been filed for this corner location. We found no record of the NNE 1/8 Corner being set. We found a 3/4" bar at the approximate centerline intersection of the county roads and in line with the fence line running south. Based on this we accepted the bar as the NNE 1/8 Corner of Section 12, Township 95 North, Range 11 West. The bar is down ±30" below the crushed rock surface. We set a 1/2" bar w/cap Iowa RLS #11442 over the top.

Plan-View

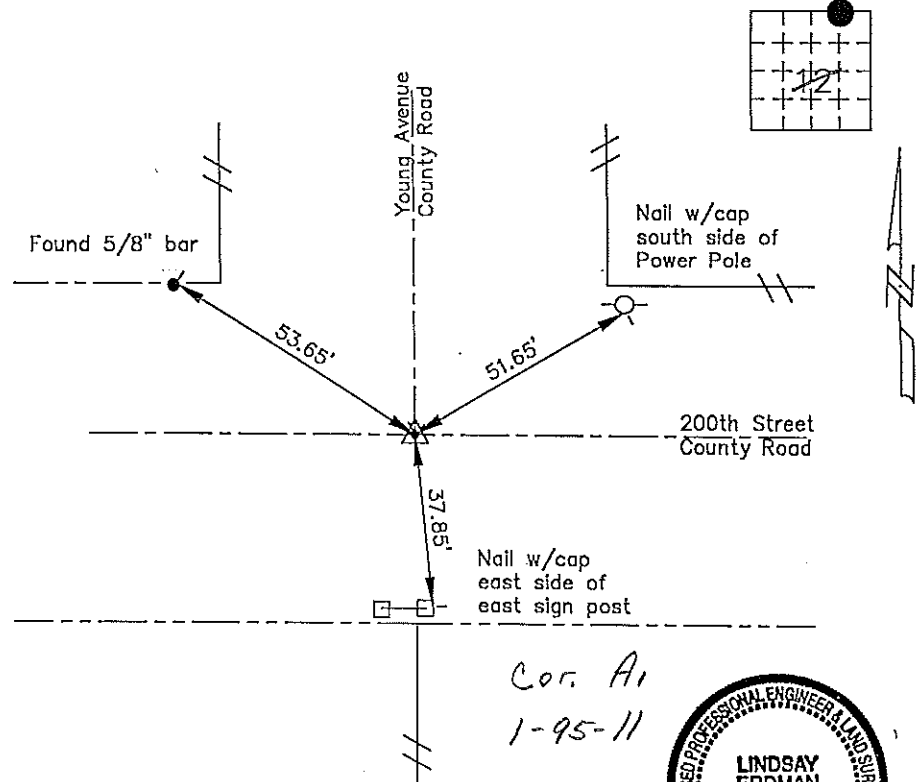

Cor. A1
 1-95-11

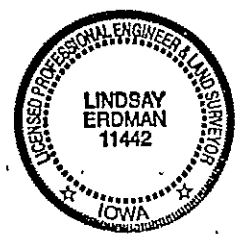

I hereby certify that the survey work was completed and this certificate was prepared by me or under my direct supervision and that I am a duly registered land surveyor under the laws of the State of Iowa.

Signature Lindsay Erdman
 Lindsay Erdman, P.E. and L.S.
 Date: 6/7/99 Reg. No. 11442

My license renewal date is December 31, 2000

Corner	Section	Twp.	Range
NNE 1/8	12	95	11

m:\c:\log\sect\chick\89043\89043.rvt