

Instr. Number: 2023-0568  
Recorded: 4/10/2023 at 4:13:04.0 PM  
Pages 1  
County Recording Fee: \$7.00  
Iowa E-Filing Fee: \$3.00  
Combined Fee: \$10.00  
Revenue Tax:  
Shirley Troyna RECORDER  
Chickasaw County, Iowa

Prepared by & Return to: Kirk D. Reicks, HRS, LLC, 19 East Main Street, New Hampton, IA 50569, Phone 641-394-2725

## United States Public Land Survey Corner Certificate

Land Survey Monument situated in  
Section 13, Township 95 North, Range 11 West of the Fifth Principal Meridian, **Chickasaw** County, Iowa.  
Not on file in the County Recorder's Office.

This certificate is being prepared in compliance with Iowa Code Chapter 355.11 because:

{  There is no certificate on file for this corner.  
 There are no longer three valid ties of record.  
 There are changes to reference ties of record.  
 There is change of monumentation of record.  
 To clarify description of record monument (ties).

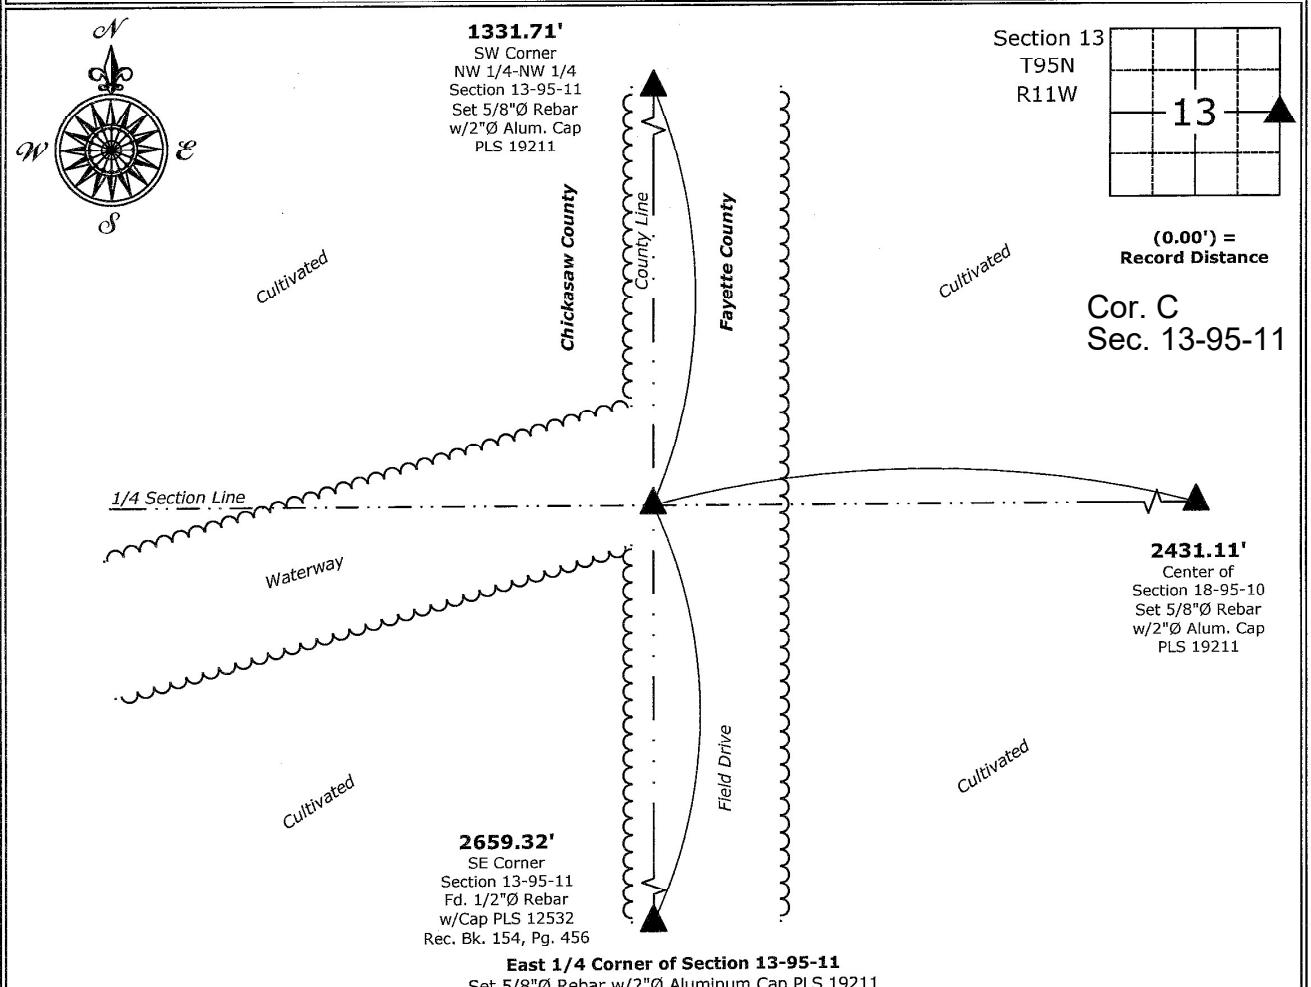
### Monument Description and Remarks:

**East 1/4 Corner:** Set 5/8"Ø Rebar w/2"Ø Aluminum Cap PLS 19211 at the extension of the 1/4 Section Line from the East 1/4 Corner to and across the Center of Section 18-95-10 at record distance from the Center with information obtained from Book S3, Page 152, on file in the Fayette County Engineer's Office, West Union, Iowa.

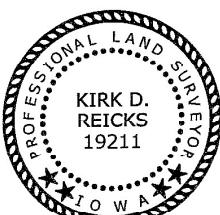
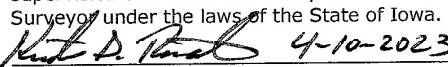
Corner was established for a survey performed in Fayette County.

## Plan View - Not to Scale

(Show a minimum of three reference ties to durable physical objects, relevant monuments and physical conditions that will enable recovery of the corner.)



East 1/4 Corner of Section 13-95-11  
Set 5/8"Ø Rebar w/2"Ø Aluminum Cap PLS 19211

 KIRK D. REICKS 19211	I hereby certify that this land surveying document was prepared and the related survey work was performed by me or under my direct personal supervision and that I am a duly licensed Land Surveyor under the laws of the State of Iowa.   Kirk D. Reicks Date: License number 19211 My license renewal date is December 31, 2024. Sheets covered by this seal: Individual sheet only	<p>List Corner to be Indexed</p> <table><thead><tr><th>Corner</th><th>Section</th><th>Township</th><th>Range</th></tr></thead><tbody><tr><td>E 1/4</td><td>13</td><td>95</td><td>11</td></tr></tbody></table> <p>Project Number: 2023-027</p> <p>FB: Fayette 4, Page(s) 48-50</p>	Corner	Section	Township	Range	E 1/4	13	95	11
Corner	Section	Township	Range							
E 1/4	13	95	11							