

Prepared by & Return to Harold - Reicks Surveying, 10 East Main Street, New Hampton, IA 50659, Ph. 641-394-2726

UNITED STATES PUBLIC LAND SURVEY CORNER CERTIFICATE

Land Survey Monuments situated in Section 12, Township 95 North, Range 11 West of the Fifth Principal Meridian, Chickasaw County, Iowa. 1., 2.) Not previously recorded in the County Recorder's office.

This certificate is being prepared in compliance with Iowa Code Chapter 355.11 because:

- 1 & 2 There is no certificate on file for this corner.
 There are no longer three valid ties of record.
 There are changes to reference ties of record.
 There is change of monumentation of record.
 To clarify description of record monument (ties).


Monument Description and Remarks:

1.) Northwest Corner NE 1/4-SE 1/4: Set 5/8"Ø rebar with 2"Ø aluminum cap PLS 19211 equidistant and online between the East 1/4 Corner and Center of Section 12.

2.) Southeast Corner: Found 5/8"Ø pipe w/aluminum cap PLS 2886 with information on a Survey and Plat made by L.P. Erdman, recorded in Bk. 134, Pgs. 108-109, on file in the Chickasaw County Recorders Office.

PLAN - VIEW

(Show a minimum of three reference ties to durable physical objects, relevant monuments and physical conditions that will enable recovery of the corner.)

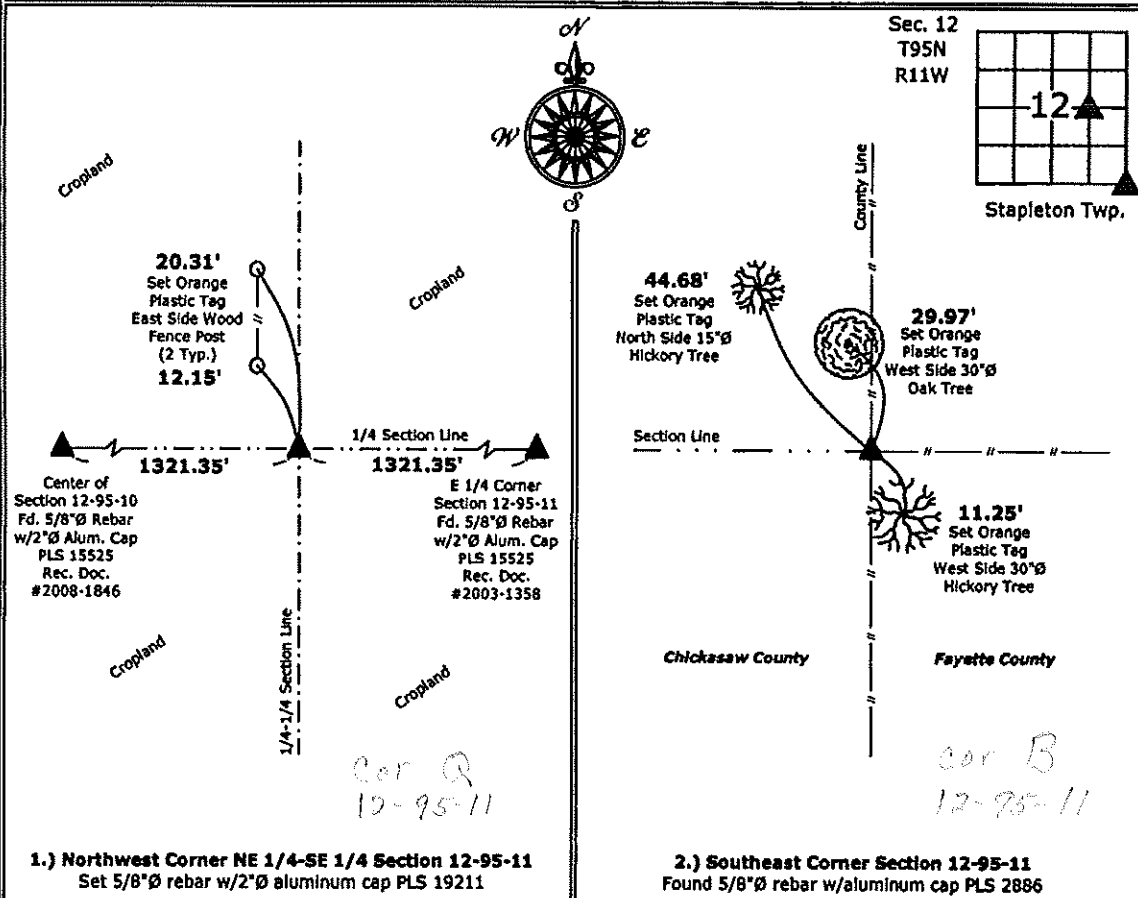

1.) Northwest Corner NE 1/4-SE 1/4 Section 12-95-11
Set 5/8"Ø rebar w/2"Ø aluminum cap PLS 19211

2.) Southeast Corner Section 12-95-11
Found 5/8"Ø rebar w/aluminum cap PLS 2886



I hereby certify that this land surveying document was prepared and the related survey work was performed by me or under my direct personal supervision and that I am a duly licensed Land Surveyor under the laws of the State of Iowa.

Kirk D. Reicks 8-15-13
Kirk D. Reicks Date:

License number 19211
My license renewal date is December 31, 2014.
Sheets covered by this seal: Individual sheet only

| List Corners to be Indexed | | | |
|----------------------------|---------|------|-------|
| Corners | Section | Twp. | Range |
| NW-NE-SE | 12 | 95 | 11 |
| SE | 12 | 95 | 11 |

Project Number: 2013-118

FB: Chickasaw 5, Pgs. 56-57