

Chickasaw Co. Recorder
Cindy Messersmith
Fee Book 2011-0660
04/25/2011 01247PM
SCC SEC COR CERT
BOOK: Page: # Pages: 1
Total Fees: \$9.00

Prepared by & Return to: Herold - Reicks Surveying, 10 East Main Street, New Hampton, NY 12553, Ph. 646-354-4225

UNITED STATES PUBLIC LAND SURVEY CORNER CERTIFICATE

Land Survey Monuments situated In Section 19, Township 95 North, Range 11 West of the Fifth Principal Meridian, Chickasaw County, Iowa. 1.) & 2.) Not previously recorded the County Recorder's office.

This certificate is being prepared in compliance with Iowa Code Chapter 355.11 because:

- There is no certificate on file for this corner.
- There are no longer three valid ties of record.
- There are changes to reference ties of record.
- There is change of monumentation of record.
- To clarify description of record monument (ties).


Monument Description and Remarks:

1.) Center of Sections: Set Survey Mark Nail with stainless steel washer PLS 15525 at the intersection of Quarter Section Lines.

2.) **East 1/4 Corner:** Set 5/8"Ø rebar with 2"Ø aluminum cap PLS 15525 at the intersection of existing possession line fences, there is no record of the perpetuation of a monument at this corner, accepted the fence corner as best evidence.

PLAN - VIEW

(Show a minimum of three reference ties to durable physical objects, relevant monuments and physical conditions that will enable recovery of the corner.)

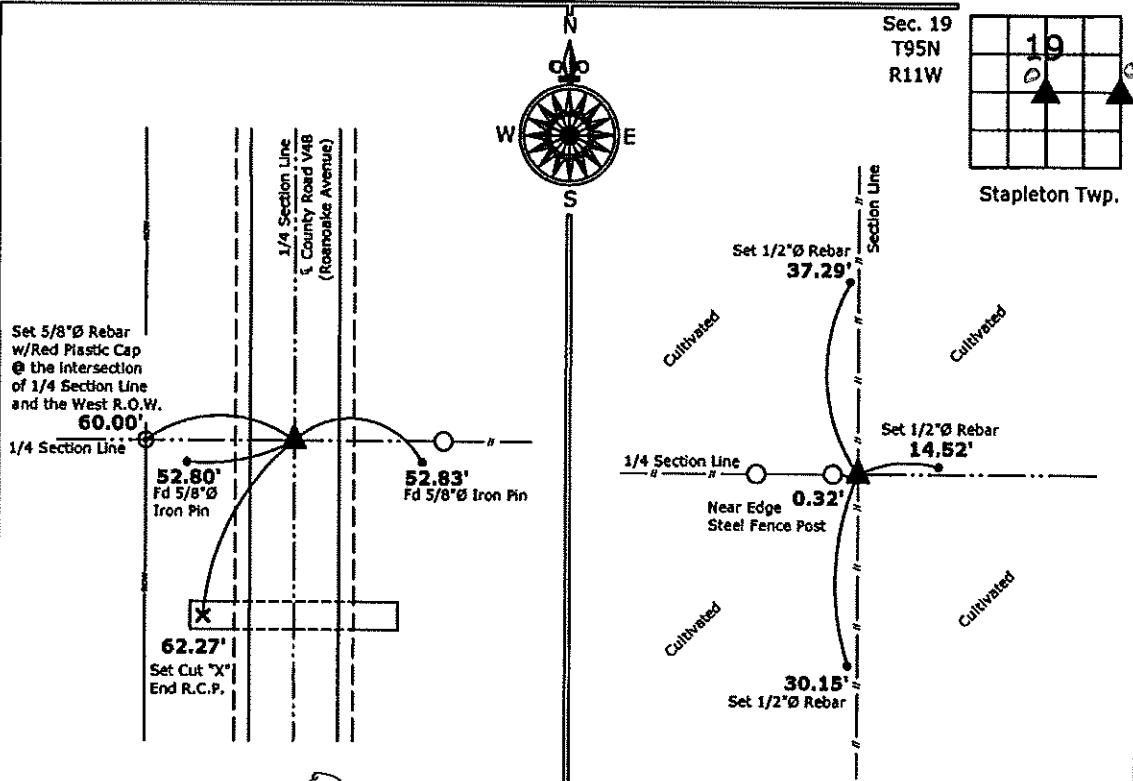

1.) Center of Section 19-95-11
Set Survey Mark Nail w/stainless steel washer PLS 15525

2.) East 1/4 Corner Section 19-95-11
Set 5/8"Ø rebar w/2"Ø aluminum cap Pls 15525



I hereby certify that this land surveying document was prepared and the related survey work was performed by me or under my direct personal supervision and that I am a duly licensed Land Surveyor under the laws of the State of Iowa.

Ron R. Herold 4-25-11

Paul R. Herold Date:
License number 15525
My license renewal date is December 31, 2012.
Check enclosed by this card. Individual license
holders are responsible for renewing their license.

List Corners to be Indexed		
Section	Twp.	Range
19	95	11
19	95	11