

Chickasaw Co. Recorder  
 Cindy Messersmith  
**Fee Book 2008-2241**  
 11/26/2008 @1020AM  
 SCC SEC COR CERT  
 Book: Page: # Pages: 1  
 Total Fees: \$7.00

*Herold - Reicks Surveying, 25 1/2 East Main Street, Suite 204, New Hampton, IA 50659, Ph. 641-394-2725*

**CORRECTIVE UNITED STATES PUBLIC LAND SURVEY CORNER CERTIFICATE**

Land Survey Monuments situated in Section 1, Township 95 North, Range 13 West of the Fifth Principal Meridian, Chickasaw County, Iowa. Previously recorded in Bk. 169, Pg. 292 in the County Recorder's office.

This certificate is being prepared in compliance with Iowa Code Chapter 355.11 because:

- There is no certificate on file for this corner.
- There are no longer three valid ties of record.
- There are changes to reference ties of record.
- There is change of monumentation of record.
- To clarify description of record monument (ties).


Monument Description and Remarks:

**Center of Section 1-95-13:** Fd. 3/4"Ø Pinched Top Pipe matching description on the previous Section Corner Certificate, the fence was replaced with a new one and all of the previous ties were gone, established 3 new ties.

This Section Corner Certificate is to supersede the one recorded October 29, 2008, Document #2008-2073, on this Document the Corner was incorrectly labeled in 2 locations.

**PLAN - VIEW**

(Show a minimum of three reference ties to durable physical objects, relevant monuments and physical conditions that will enable recovery of the corner.)

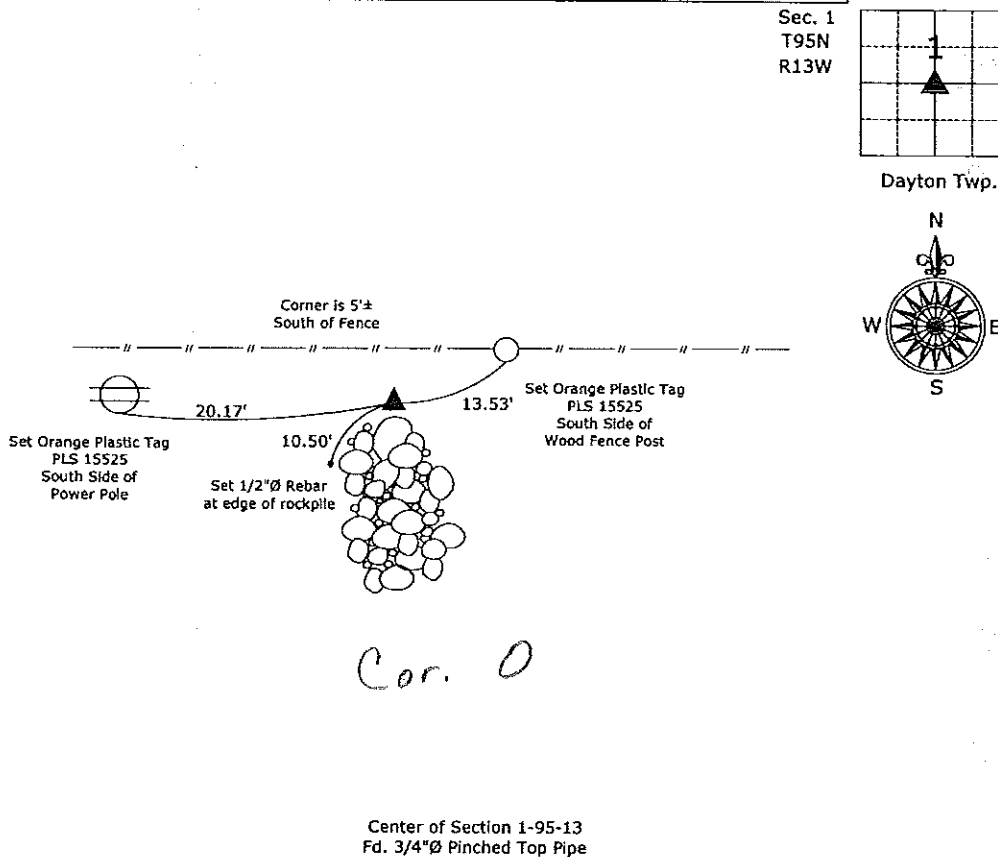

*Cor. 0*

Center of Section 1-95-13  
 Fd. 3/4"Ø Pinched Top Pipe



I hereby certify that this land surveying document was prepared and the related survey work was performed by me or under my direct personal supervision and that I am a duly licensed Land Surveyor under the laws of the State of Iowa.  
*Paul R. Herold* 11-26-08  
 Paul R. Herold Date:  
 License number 15525  
 My license renewal date is December 31, 2008.  
 Sheets covered by this seal: Individual sheet only

List Corners to be Indexed			
Corners	Section	Twp.	Range
Center	1	95	13

Project Number: 2008-019  
 FB: Chickasaw County 2, Pgs. 1-10

File: S:\Projects\2008\2008-019\dwg\2008-019.dwg, 11/26/2008 08:03:04