

Chickasaw Co. Recorder
 Cindy Messersmith
Fee Book 2016-0422
 04/01/2016 @0237PM
 SCC SEC COR CERT
 Book: Page: # Pages: 1
 Total Fees: \$7.00

Prepared by & Return to: Herold - Reicks Surveying, 10 East Main Street, New Hampton, IA 50659, Ph. 641-394-2725

UNITED STATES PUBLIC LAND SURVEY CORNER CERTIFICATE

Land Survey Monuments situated in Section **23**, Township **95 North**, Range **11 West** of the Fifth Principal Meridian, **Chickasaw County, Iowa. 1.) & 2.)** Not previously recorded in the County Recorder's office.

This certificate is being prepared in compliance with Iowa Code Chapter 355.11 because:


- 1 & 2 There is no certificate on file for this corner.
- There are no longer three valid ties of record.
- There are changes to reference ties of record.
- 2 There is change of monumentation of record.
- To clarify description of record monument (ties).

Monument Description and Remarks:

- 1.) NW Corner:** Fd. a "T" Post (Steel Fence Post) at the intersection of Vanderbilt Avenue & 220th Street matching ties obtained from the County Engineers Field Book, Stapleton Twp., Section 15, Corner "B"
- 2.) W 1/4 Corner:** Fd. 1/2"Ø Rebar 18" Deep, Set 5/8"Ø Rebar w/2"Ø Alum. Cap over found monument in order to facilitate future recovery of monument, corner recovered from information obtained from the County Engineer's Office in Field Book Stapleton Twp., Section 22, Corner "C"

PLAN - VIEW

(Show a minimum of three reference ties to durable physical objects, relevant monuments and physical conditions that will enable recovery of the corner.)

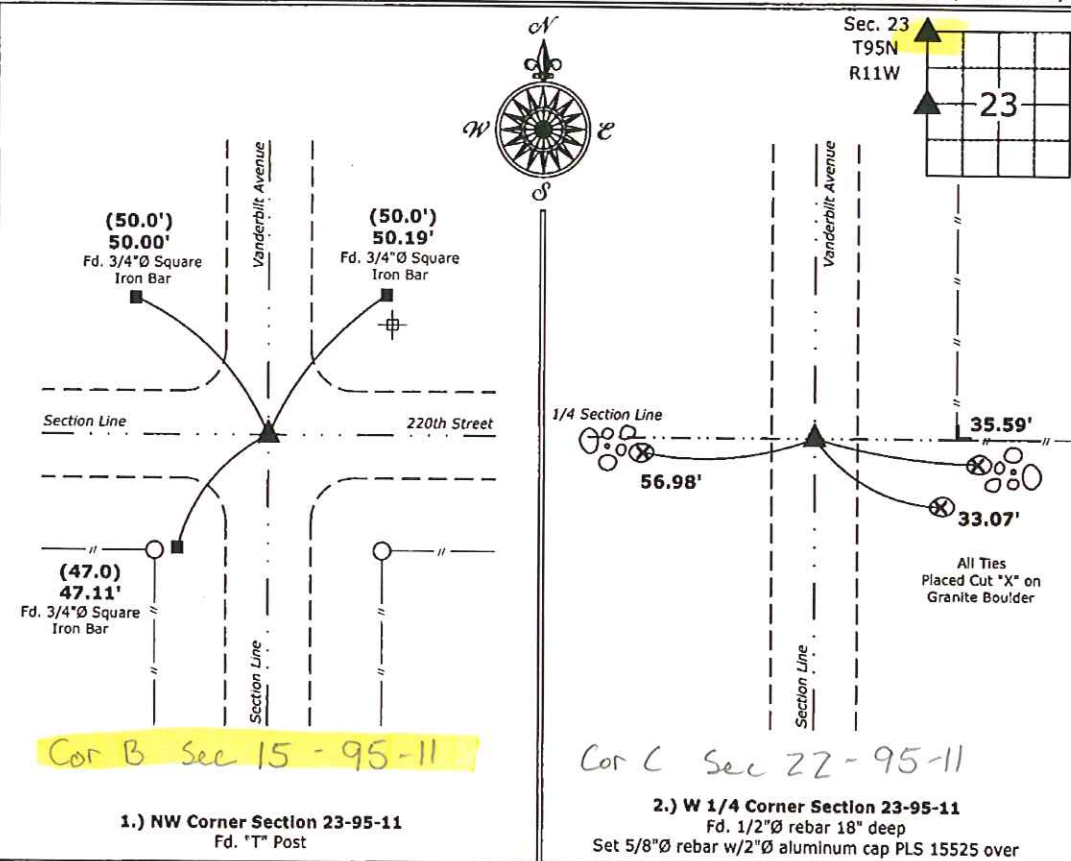

I hereby certify that this land surveying document was prepared and the related survey work was performed by me or under my direct personal supervision and that I am a duly licensed Land Surveyor under the laws of the State of Iowa.

Paul R. Herold 4-1-16
 Paul R. Herold Date:
 License number 15525
 My license renewal date is December 31, 2016.
 Sheets covered by this seal: Individual sheet only

List Corners to be Indexed			
Corners	Section	Twp.	Range
NW	23	95	11
W 1/4	23	95	11

Project Number: 2016-039
 FB: Chickasaw County 7, Pgs. 55-56

File: S:\L3D Projects\County Control Systems\CHICKASAW\CHICK-37.dwg, 4/1/2016 10:40:15 AM