

Fee \$1.00

2003 DEC 31 AM 9 19



CINDY MESSERSMITH
COUNTY RECORDER

Prepared by: Erdman Engineering, P.C., 708 Commerce Drive, P.O. Box 246, Decorah, Iowa 52101 (563) 382-4194


United States Public Land Survey Corner Certificate
ofLand Survey Monuments situated in Section 27, Township 95, Range 11 West of
the 5th Principal Meridian in Chickasaw County, Iowa. Previously recorded in
does not apply in the county Recorder's Office.

Monument Description and Remarks: This certificate is prepared in accordance with Section 193C of the Code of Iowa. No previous certificate has been filed for this corner location. Based on Chickasaw County Engineer's Reference Ties we found two 1" diameter steel pipes and a $\frac{3}{4}$ " diameter steel bar that have been used previously as tie markers. From these ties we found a 1" diameter steel pipe at the approximate centerline of the county road and in line with the fence line running north. County Engineer's Reference Ties show only that an "IP" had been found in 1983. No IP was found now. We used the 1" diameter steel pipe as the best evidence of the location of the S $\frac{1}{4}$ Corner of Section 27, Township 95 North, Range 11 West.

Plan-View

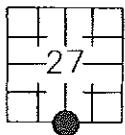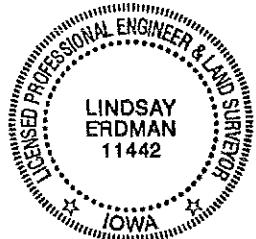

Cor. A

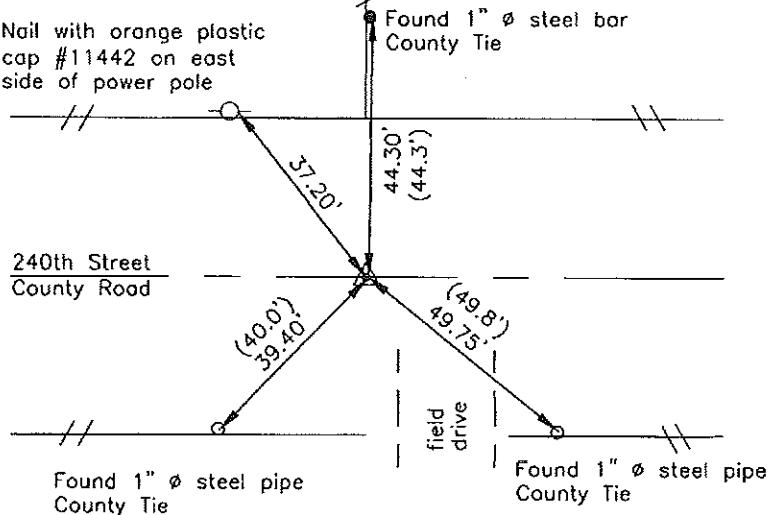

I hereby certify that the survey work was completed and this certificate was prepared by me or under my direct supervision and that I am a duly registered land surveyor under the laws of the State of Iowa.

Signature 
Lindsay Erdman, P.E. and P.L.S. Iowa License Number 11442

Date: 12/23/03

My license renewal date is December 31, 2004

Corner(s) to be Indexed

Corner	Section	Township	Range
S 1/4	27	95	11

Section 34-96-11
As referred to in
Engt. in the Book

TEKIPPE ENGINEERING, P.C., 128 South Vine Street, West Union, Iowa 52175 Phone (319) 422-5131

UNITED STATES PUBLIC LAND SURVEY CORNER CERTIFICATE

OF

Land Survey Monuments situated in Section 3 1/4, Township 95 N North, Range 11 West, of the Fifth Principal Meridian, CHICKASAW County, Iowa.

Previously recorded in NONE (book, page, document number, etc.) in County Recorder's Office.

(Show reason for preparing this certificate, the evidence and detailed procedures used in establishing the corner positions and monumentation found or placed.)


Monument Description and Remarks: N 1/4 CORNER SECTION 3, T 95 N R 11 W: FOUND T-BAR AS DESCRIBED AS SET ON A SURVEY AND PLAT MADE BY

HAROLD D. BLESSING, RECORDED MAY 23, 1977, BOOK 114, PAGES 176-177, ON FILE IN THE CHICKASAW COUNTY RECORDERS OFFICE.

S 1/4 CORNER SECTION 3, T 95 N R 11 W: FOUND 1/2"φ REBAR w/cap 7060 AS DESCRIBED AS SET ON A SURVEY AND PLAT MADE BY LYLE G. TEKIPPE, RECORDED JUNE 7, 1990, BOOK 145, PAGES 95-98, ON FILE IN THE CHICKASAW COUNTY RECORDERS OFFICE.

PLAN - VIEW

(Show a minimum of three reference ties to durable physical objects, relevant monuments and physical conditions that will enable recovery of the corner.)

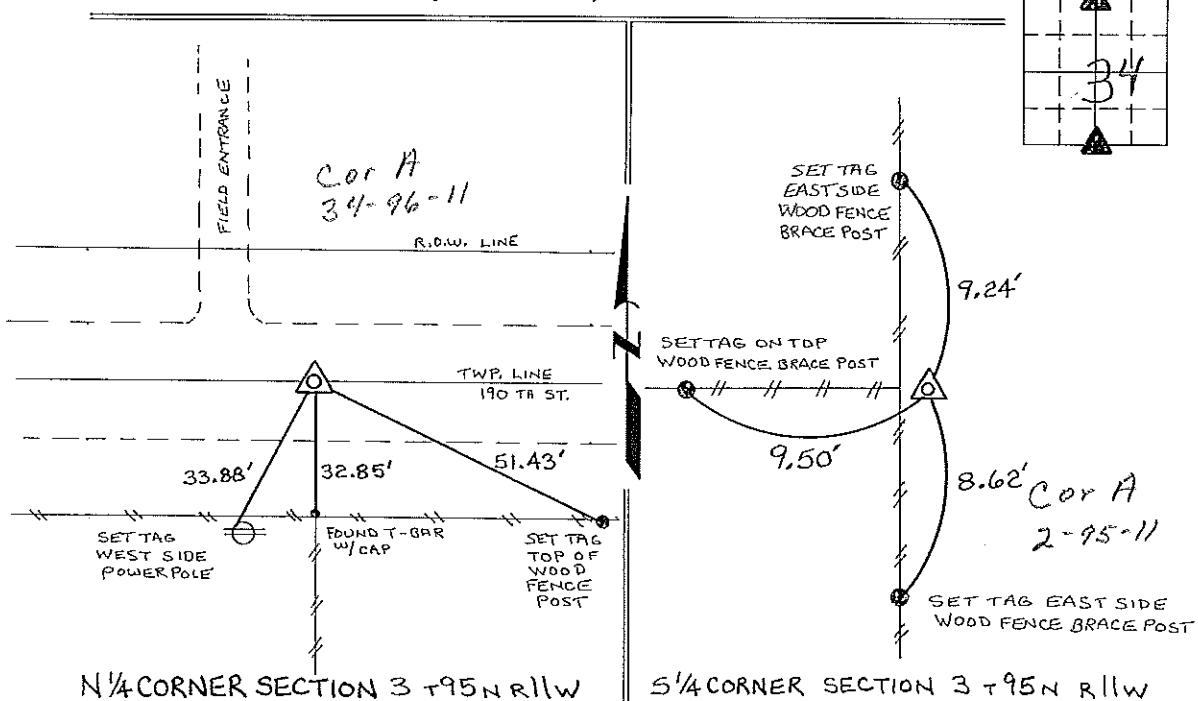

N 1/4 CORNER SECTION 3 T 95 N R 11 W

S 1/4 CORNER SECTION 3 T 95 N R 11 W

I hereby certify that the survey work was completed and this certificate was prepared by me or under my direct personal supervision and that I am a duly registered land surveyor under the laws of the state of Iowa.

Signature: Lyle G. TeKippe
Lyle G. TeKippe

Date: 5-17-96 Reg. No. 7060
My Registration Renewal Date is December 31, 1998

Seal



List Corners to be Indexed

Corners Section Twp. Range

N 1/4 3 95 N 11 W
Cor A 34-96-11

S 1/4 3 95 N 11 W

Corner A 3-95-11

Placed in the book
6/17/96