

Prepared by & Return to: Herald - Reicks Surveying, 10 East Main Street, New Hampton, IA 50655, Ph. 641-394-2725

UNITED STATES PUBLIC LAND SURVEY CORNER CERTIFICATE

Land Survey Monuments situated in Section **35**, Township **95 North**, Range **11 West** of the Fifth Principal Meridian, **Chickasaw County, Iowa 1., 2.)** Not previously recorded in the County Recorder's office.

This certificate is being prepared in compliance with Iowa Code Chapter 355.11 because:


- 1 & 2 There is no certificate on file for this corner.
- There are no longer three valid ties of record.
- There are changes to reference ties of record.
- There is change of monumentation of record.
- To clarify description of record monument (ties).

Monument Description and Remarks:

- 1.) Northeast Corner NW 1/4-SE 1/4:** Set 5/8"Ø rebar w/2"Ø aluminum cap PLS 19211 equidistant and on line between the East 1/4 Corner and Center of Section 35.
- 2.) Southeast Corner SW 1/4-SE 1/4:** Set 5/8"Ø rebar w/2"Ø aluminum cap PLS 19211 equidistant and on line between the South 1/4 and Southeast Corners of Section 35.

PLAN - VIEW

(Show a minimum of three reference ties to durable physical objects, relevant monuments and physical conditions that will enable recovery of the corner.)

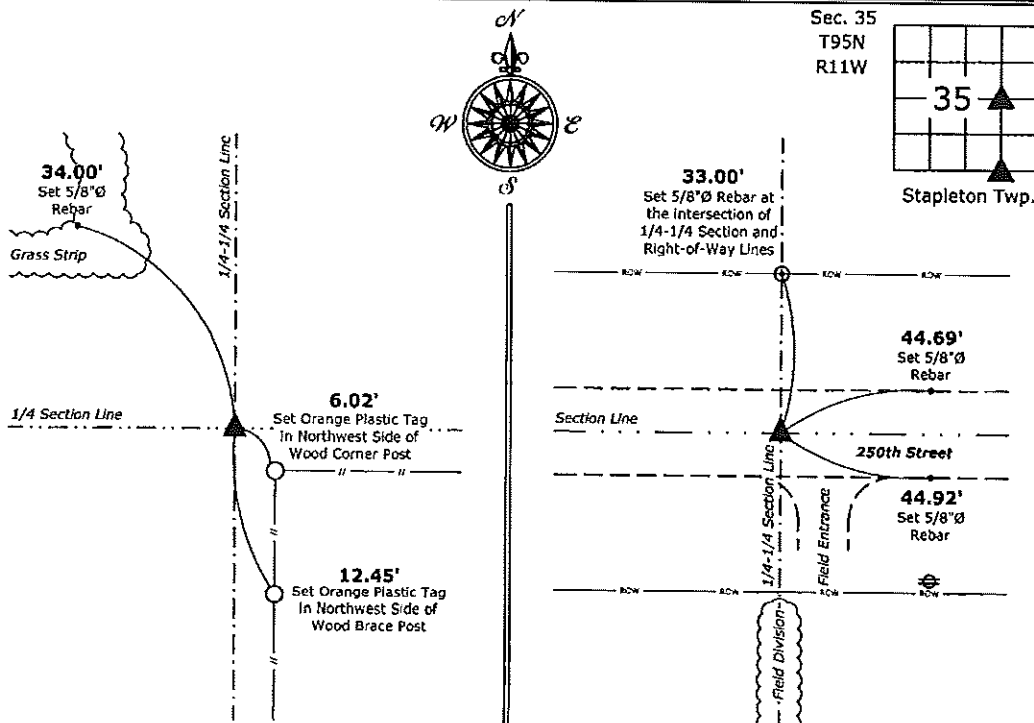

1.) Northeast Corner NW 1/4-SE 1/4 Section 35-95-11
 Set 5/8"Ø rebar w/2"Ø aluminum cap PLS 19211

2.) Southeast Corner SW 1/4-SE 1/4 Section 35-95-11
 Set 5/8"Ø rebar w/2"Ø aluminum cap PLS 19211



I hereby certify that this land surveying document was prepared and the related survey work was performed by me or under my direct personal supervision and that I am a duly licensed Land Surveyor under the laws of the State of Iowa.

Kirk D. Reicks 6-8-15
 Kirk D. Reicks Date:
 License number 19211
 My license renewal date is December 31, 2016.
 Sheets covered by this seal: Individual sheet only

List Corners to be Indexed

Corners	Section	Twp.	Range
NE-NW-SE	35	95	11
SE-SW-SE	35	95	11

Project Number: 2015-083

FB: Chickasaw County 7, Pgs. 32, 34