

2004 FEB 9 AM 9 12

CHIDY MESSERSMITH
 COUNTY RECORDER

TeKIPPE ENGINEERING, P.C., 128 South Vine Street, West Union, Iowa 52175 Phone (563) 422-5131

UNITED STATES PUBLIC LAND SURVEY CORNER CERTIFICATE

OF


Land Survey Monuments situated in Section 4, Township 95 North, Range 11 West of the Fifth Principal Meridian, CHICKASAW County, Iowa.
 Previously recorded in none in County Recorder's Office.
 (book, page, document number, etc.)

(Show reason for preparing this certificate, the evidence and detailed procedures used in establishing the corner positions and monumentation found or placed.)


Monument Description and Remarks: SW Corner SE 1/4 - NE 1/4 Section 4 T95N, R11W:
Set 1/2"Ø rebar w/2"Ø aluminum cap PLS 15525 equidistant and on line between the
Center of the Section and the E 1/4 Corner, the monument as shown on a Survey
and Plat made by Roger D. Hanson (Recorded in Deeds Bk. 105, Pgs. 383-385), a T-Bar
w/stainless steel cap, was found and ignored due to the fact the survey did
not have sufficient control to have established to correct corner position, only an
assumption that the fence corner was correct, and there is no indication that this
corner had ever been correctly established.

PLAN - VIEW

(Show a minimum of three reference ties to durable physical objects, relevant monuments and physical conditions that will enable recovery of the corner.)

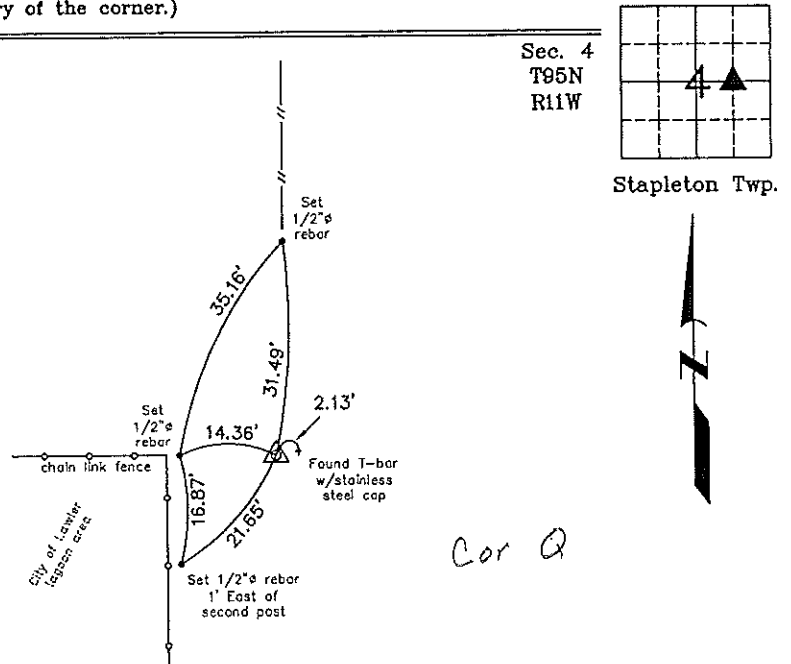


Sec. 4
 T95N
 R11W

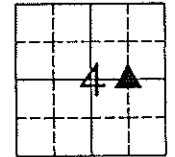

Stapleton Twp.

Cor Q

SW Corner SE 1/4 - NE 1/4 Section 4 T95N R11W
 Set 1/2"Ø rebar w/2"Ø aluminum cap PLS 15525

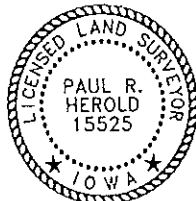

I hereby certify that this land surveying document was prepared and the related survey work was performed by me or under my direct personal supervision and that I am a duly licensed Land Surveyor under the laws of the State of Iowa.

Paul R. Herold 2-5-04
 Paul R. Herold Date
 License number 15525
 My license renewal date is December 31, 2004.
 Sheets covered by this seal: Individual

List Corners to be Indexed			
Corners	Section	Twp.	Range
SW-SE-NE	4	95N	11W

Filed 2-11-04

X:\Section Corners\Sec. 04\4-95-11n.dwg
 Project Number 04001.LS
 FB. 46K PG. 42-49