

Section 2-95-11  
 As referred to in  
 Eng. The Book

TeKIPPE ENGINEERING, P.C., 128 South Vine Street, West Union, Iowa 52175 Phone (319) 422-5131

UNITED STATES PUBLIC LAND SURVEY CORNER CERTIFICATE

OF

Land Survey Monuments situated in Section 4<sup>5</sup>, Township 95 North, Range 11 West of the Fifth Principal Meridian, CHICKASAW County, Iowa. Previously recorded in none in County Recorder's Office. (book, page, document number, etc.)

(Show reason for preparing this certificate, the evidence and detailed procedures used in establishing the corner positions and monumentation found or placed.)


Monument Description and Remarks: W 1/4 Corner Section 4 T95N R11W: Set 1/2"Ø rebar w/2"Ø aluminum cap LS 7060, 18" deep (Corner falls in cultivated field).

This corner position was established by extending a line from the E 1/4 Corner through the calculated position of the Center of Section 4 and intersecting a line beginning at the NW Corner and extended south, paralleling 1436 feet of section line fence. This corner position places a N/S fence line between the NW Cor. and the W 1/4 Cor. 3 feet East of line and a N/S fence line between the SW Cor. and the W 1/4 Cor. 3 feet West of line. This position is within 6 feet of the prorated North/South distance and 6.8 feet West of a straight mile.

PLAN - VIEW


Project Number 00157.LS  
 FB 48H PC. 4-17

(Show a minimum of three reference ties to durable physical objects, relevant monuments and physical conditions that will enable recovery of the corner.)

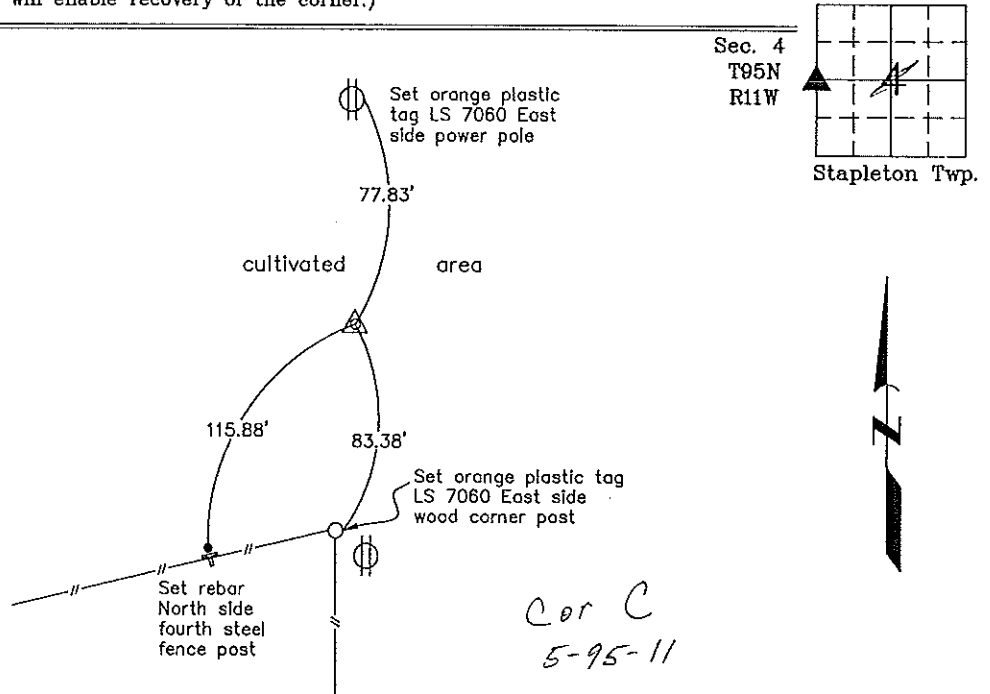

W 1/4 Corner Section 4 T95N R11W  
 Set 1/2"Ø rebar w/2"Ø aluminum cap LS 7060

Cor C  
 5-95-11

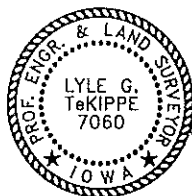

I hereby certify that this land surveying document was prepared and the related survey work was performed by me or under my direct personal supervision and that I am a duly licensed Land Surveyor under the laws of the State of Iowa.

*Lyle G. TeKippe* 9-6-00  
 Lyle G. TeKippe Date  
 License number 7060  
 My license renewal date is December 31, 2000.  
 Sheets covered by this seal: Individual

List Corners to be Indexed			
Corners	Section	Twp.	Range
W 1/4	4	95	11

Cor. 5

2000-1554

Engineer's Copy