
Herold - Reicks Surveyji		Daw Hamatas ID ED	559. Ph. 641-24	14-2725. Fax. 641	394-2178
Herold - Reicks Surveyii Hinter	ng, 10 East Main Street STATES PUBLIC	I AND SURVEY (	CORNER CE	RTIFICATE	
UNITEL  Land Survey Monumen  Meridian, Chickasaw office.  This certificate is being p  with Iowa Code Chapter	its situated in Section 4 County, Iowa. Previous prepared in compliance	1, Township 95 North Sly recorded in Bk. 10  There is no There are n  There are c	n, Range 11 We 57, Pg. 310 in certificate on file o longer three va hanges to refere	est of the Fifth Prir the County Record for this corner. alid ties of record. nce ties of record. ntation of record.	
Monument Description a	nd Remarks:	☐ To clarify d	escription of reco	ord monument (ties)	•
South 1/4 Corner: Se	t Survey Mark Nail with S certificate. The previous avement Overlay in 2009	monument (Iowa D.O.)	PLS 19211 with in . 3.5" Aluminum	nformation obtained Disc) was obliterate	from d due to
		PLAN - VIEW			
(Show a minimum of three refe	rence ties to durable physical obj	ects, relevant monuments and	l physical conditions t	Sec. 4 T95N	the corner.)
W S E	City of Lawler	1/4 Section Line	House Foundatie	•	oleton Twp.
	Found X-Nails East Side Power Pole 45.47'			Tie used SW Corner of Ho ferenced due to crumbling	
Section Line  ¶ Iowa Hwy. 24					
	<b>35.2</b> Set 1/2°Ø	Rebar   ;	49.70° Found X-Nails West Side Power P	ole	- <del></del>
	Cemetery	PHIVATE		cemetery A	
		uth 1/4 Corner Section lark Nall w/Stainless Steel		1	
KIRK D. REICKS 19211	I hereby certify that this is was prepared and the rela performed by me or under supervision and that I am Surveyor under the laws of Kirk D. Reicks	ted survey work was my direct personal a duly licensed Land	II.	Corners to be Indexed ection Twp. 4 95	Rang 11
Wind Water	License number 19211  My license renewal date is December 31, 2010.  Sheets covered by this seal: Individual sheet only		Project Number: 2009-158 FB: Lawler 1, Pg. 3		

Project Number: 2009-158 FB: Lawler 1, Pg. 3

My license renewal date is December 31, 2010. Sheets covered by this seal: Individual sheet only

## TEKIPPE ENGINEERING, P.C., 128 South Vine Street, West Union, Iowa 52175 Phone (319) 422-5131 UNITED STATES PUBLIC LAND SURVEY CORNER CERTIFICATE

Section 4-95-11 As referred to in Engr. The Book

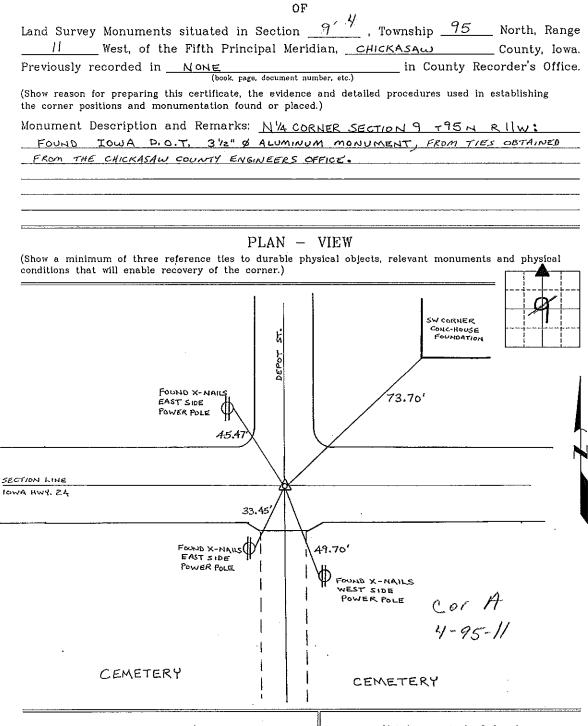



I hereby certify that this land surveying document was prepared and the related survey work was performed by me or under my direct personal supervision and that I am a duly licensed Land Surveyor under the laws of the State of lowa.

Lyc G. Ockeyn 4-28-98

Lyle G. TeKippe Date

License number 7080

My license renewal date is December 31, 1998. Sheets covered by this seal: Individual

List Corners to be Indexed
Corners Section Twp. Range

N 1/4 9 95N 11W

Corner A 4/95-11

Placed in the look 4/34/96