
COUNTY ENGINEER'S SECTION CORNER PRESERVATION RECORD

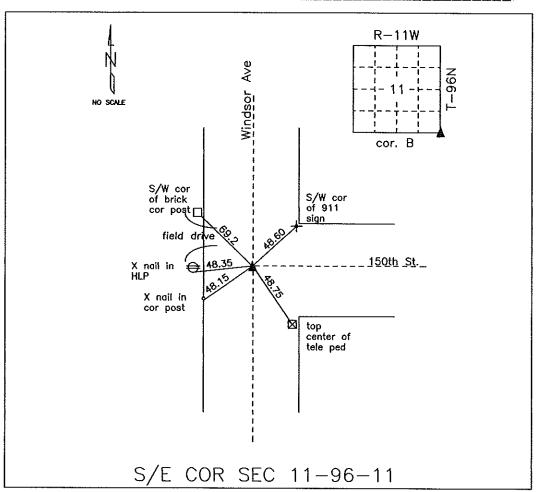

MONUMENT DESCRIPTION AND NARRATIV	/E Found 1/2" rebar beside bent over square bar.		
Previously recorded by Lindsay Erdman in Book 148 Po	age 251 on 10-03-91		
All ties are GPS surveyed.			
I AM NOT A REGISTERED LAND SURVEYOR UNDER THE LAWS OF THE STATE OF IOWA			
JIM FOSTER CHICKASAW CO. DATE: 11/15/	10		

	DOCUMENT No. U1US 47 FILED FOR RECORD THE 2nd 2nd December 19.9 TRANSFER FEE . \$ 5.00 O'CLOCK A. M. BOOK 1.48. Deeds.	DAY OF STATE OF IOWA, CHICKASAW COUNTY, 12. AT . 1.0527/ MARY C. MURRAY, Records
. 01	UNITED STATES PUBLIC LAND SU Land Survey Monuments situated in Section Previously recorded in Does Not Amey (Show reason for preparing this certificate, the evidence and detailed p Monument Description and Remarks)	RVEY CODNED CEDEVELCATE
Cardian 11-96	To IN OF	AVET CORNER CERTIFICATE
De reform	Land Survey Monuments situated in Section	, Township96 Range
H3 Book	Previously recorded in Does Nor Meridian, &	County, Iowain County Recorder's Office.
Eng.	(Show reason for preparing this certificate, the evidence and detailed p mentation found or placed.) Monument Description and Remarks:	rocedures used in establishing the corner positions and monu-
•		
	(Show a minimum of three reference ties to durable physical objects, recovery of the corner.)	IEW
	/	Pysical Conditions that will enable
	WIF CORNER,	- - - - - - - - - -
	SET ±" BAL	┠╌┞╌┧╌╏
	50,90' 04 51,93	\$
	STEEL COR.	
	Post Sert's	54 CORNER
	Car. Cof 11-96-11	NAILS & STEEL GR. POST
	Po Po	WER POLE
	SW CORNER,	100 m
	FOUND 2" BAR	
		"X" HAILS POWER POLE
	130 Accor. Bog 11-96-11	
	STEEL COL, NO	Corner A of 12-96-11
v	"X" NAILS "X" NAILS IN COL. POST	
	hereby certify that the	
	was prepared by me or under my direct personal supervision and that I am a duly registered land surveyor under the laws of the state of lowa.	List Corners to be Indexed Corners Section Twp Range
	Signature: Name typed or printed: L. F. EROMAN	W# Loe. 12 96 11
	Date: 10-03-9/ Reg. No. 2886	SW 12 96 11
	P. ERDAN	5\$ 12 96 11
	Market Constant Const	,
	SEAL 2886	Placed in 12/91 tie Book 12/91
	10 W B	t: Book 12/4
	good William Comment	ω
	14.78	