

000001 000002 000003 000585

United States Public Land Survey Corner Certificate

Land Survey Monument situated in
Section **22**, Township **96** North, Range **11** West of the Fifth Principal Meridian, **Chickasaw** County, Iowa.
Not on file in the County Recorder's office.

This certificate is being prepared in compliance with Iowa Code Chapter 355.11 because:

- ☒ There is no certificate on file for this corner.
☐ There are no longer three valid ties of record.
☐ There are changes to reference ties of record.
☐ There is change of monumentation of record.
☐ To clarify description of record monument (ties).


Monument Description and Remarks:

Northeast Corner NW 1/4-NW 1/4: Set 5/8"Ø Rebar with Aluminum Cap PLS 19211 equidistant and online between the Northwest and North 1/4 Corners of said Section.

An extensive search of all of the records within the County offices was performed as part of the section corner recovery. No records were located of the perpetuation of a monument at this corner.

Plan View

(Show a minimum of three reference ties to durable physical objects, relevant monuments and physical conditions that will enable recovery of the corner.)

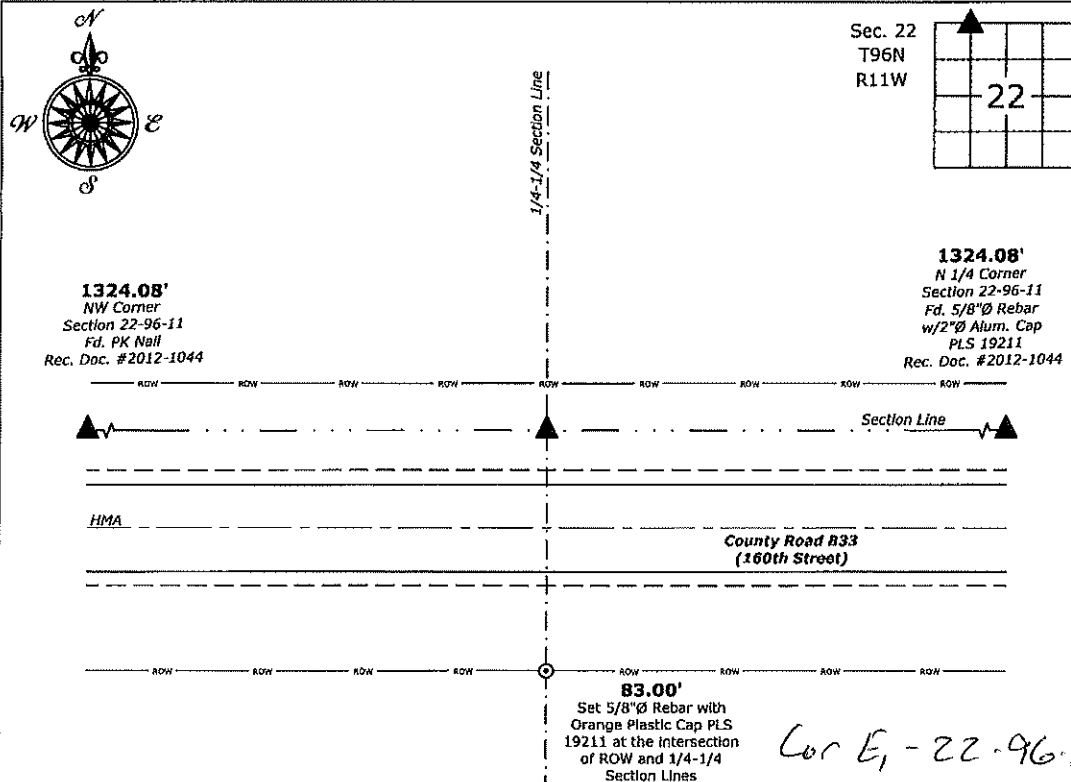

Northeast Corner NW 1/4-NW 1/4 of Section 22-96-11
Set 5/8"Ø Rebar with Aluminum Cap PLS 19211



I hereby certify that this land surveying document was prepared and the related survey work was performed by me or under my direct personal supervision and that I am a duly licensed Land Surveyor under the laws of the State of Iowa.

Kirk D. Reicks 2-14-2020
Kirk D. Reicks Date:

License number 19211
My license renewal date is December 31, 2020.
Sheets covered by this seal: Individual sheet only

List Corner to be Indexed

Corner	Section	Twp.	Range
NE-NW-NW	22	96	11

Project Number: 2020-009

FB: Chickasaw 10, Pgs. 10-12

File: S:\ Projects - NHO\County Control Systems - NHO\CHICKASAW\CHICK-24\CHCK-24.dwg, 2/13/2020 3:58:50 PM