ζ,	DOCUMENT No. 01374	FILED FOR RECORD THE 27th DAY OF	STATE OF IOWA, CHICKASAW COUNTY:
Ç	RECORDING FEE \$6.00	December 19.9.6. At 8:30	Seithall Ross, Record
- 5	TRANSFER FEE - \$	O'CLOCK A.M. 200K. 1.6.2. De.eds PAGE4.97	By Dep

Section 34-96-11
As referred to in
Engr. The Book

Prepared by: Erdman Engineering P.C. 708 Commerce Drive, P.O. Box 246, Decorch Iowo, 52101 Phone (319)382-4194, Fox (319)382-3623

United States Public Land Survey Corner Certificate

·of


Land Survey Monuments situated in Section<u>. 35</u> Township<u>, 96</u> Range<u>, 11</u> of the Fifth Principle Meridian, <u>Chickasow</u> County, lowo. Previously recorded in <u>does not apply</u> in County Recorders Office.

(Show reason for preparing this certificate, the evidence and detailed procedures used in establishing the corner positions and manumentation found or placed.)

Monument Description and Remarks: This certificate is prepared in accordance with Section 355.11 of the 1995 Code of lowa. No previous certificate has been filed for this corner location. Based on County Engineer's Reference Ties we found a 1° iron pipe down ± 1 ° below the crushed rock surface at the W 1/4 corner of Sec. 35-96-11. We did not find any of the previous tie markers but the description for the W 1/4 matched what we found at the corner location.

Plan-View

(Show a minimum of three reference tles to durable physical objects, relevant monuments and physical conditions that will enable recovery of the corner.)

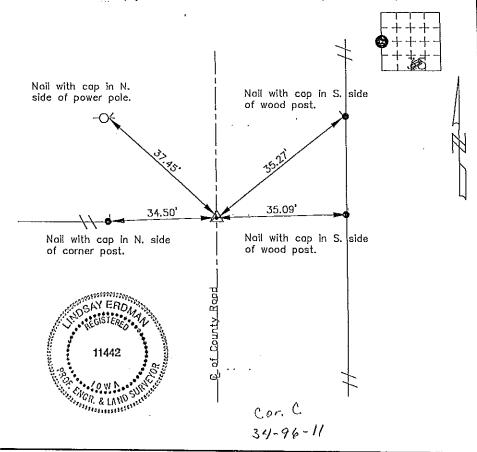

I hereby certify that the survey work was completed and this certificate was prepared by me or under by direct supervision and that I am a duly registered land surveyor under the lows of the State of lawa.

Signature Lindsoy Erdman, 17.E. and L.S.

Date: 12/10/96 Reg. No. 11442

My license will be renewed

Corners Section Twp. Range
W 1/4 35 96 11

kurten6152 10-28-95

BOOK PAGE 497