



Prepared by: Erdman Engineering, P.C., 708 Commerce Drive, P.O. Box 246, Decorah, Iowa, (563)382-4194

UNITED STATES PUBLIC LAND SURVEY CORNER CERTIFICATE
 OF

Land Survey Monuments situated in Section 19, Township 97 North, Range 11 West, of
 the Fifth Principal Meridian, Chickasaw County, Iowa, Previously recorded in does not apply in the
 County Recorder's Office.

Monument Description and Remarks:


This certificate is prepared in accordance with Section 355.11 of the Code of Iowa. No previous certificates have been filed for these corner locations.

Center Section: We found no record of the Center of Section 19 being set. We found no evidence of a monument in the field other than an existing fence corner with fence lines running north, south, and east. We found the N 1/4 Corner, S 1/4 Corner, E 1/4 Corner and W 1/4 Corner. We computed the location of the Center Section at the intersection of the lines from the opposite quarter corners. This location was ±14' south and 18' east of the fence corner. We used the fence corner as the Center of Section 19, Township 97 North, Range 11 West. We set a 1/2" diameter steel bar with 1 1/2" aluminum cap #11442 on the west side of the post.


PLAN-VIEW

(NOT TO SCALE)

Center Section
 Existing fence corner.
 Set 1/2" diameter steel
 bar with 1 1/2" aluminum
 cap #11442 on west
 side of the post.

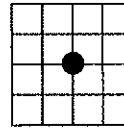

SECTION 19

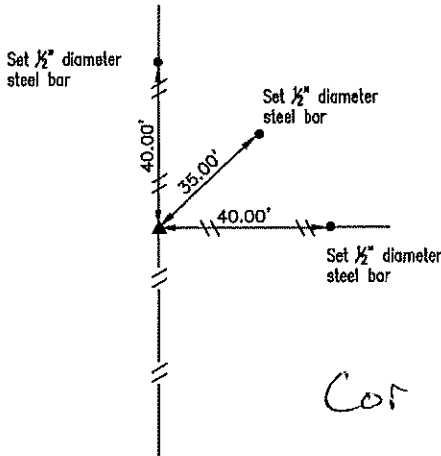

Cor O
 19-97-11



I hereby certify that this land surveying document was prepared and the related survey work was performed by me or under my direct personal supervision and that I am a duly licensed Land Surveyor under the laws of the State of Iowa.

Lindsay Erdman 3/18/19 Date

Lindsay Erdman, P.E. & P.L.S.
 Licensed Professional Land Surveyor
 Iowa License Number 11442
 My license renewal date is December 31, 2020
 Pages or sheets covered by this seal: THIS SHEET ONLY



List Corner(s) to be Indexed

Corner(s)	Section	Township	Range
C.S.	19	97N	11W

ERDMAN
ENGINEERING, P.C.
 CIVIL ENGINEERING & LAND SURVEYING
 Decorah, Iowa