


Prepared by: Erdman Engineering, P.C., 708 Commerce Drive, P.O. Box 246, Decorah, Iowa 52101 (563) 382-4194

United States Public Land Survey Corner Certificate  
 of 29

Land Survey Monuments situated in Section 28, Township 97, Range 11 West of the 5th Principal Meridian in Chickasaw County, Iowa. Previously recorded in does not apply in the county Recorder's Office.

Monument Description and Remarks: This certificate is prepared in accordance with Section 355.11 of the Code of Iowa. No previous certificate has been filed for this corner location. We found no record of the WSW 1/8 Corner being set. We found no evidence of a monument in the field other than the county road and a fence line running west. We found the SW Corner and the W 1/4 Corner. We set a 1/2" diameter steel bar with 1 1/2" aluminum cap #11442 on line and midway between the SW Corner and the W 1/4 Corner as the WSW 1/8 Corner of Section 28, Township 97 North, Range 11 West.

Plan-View

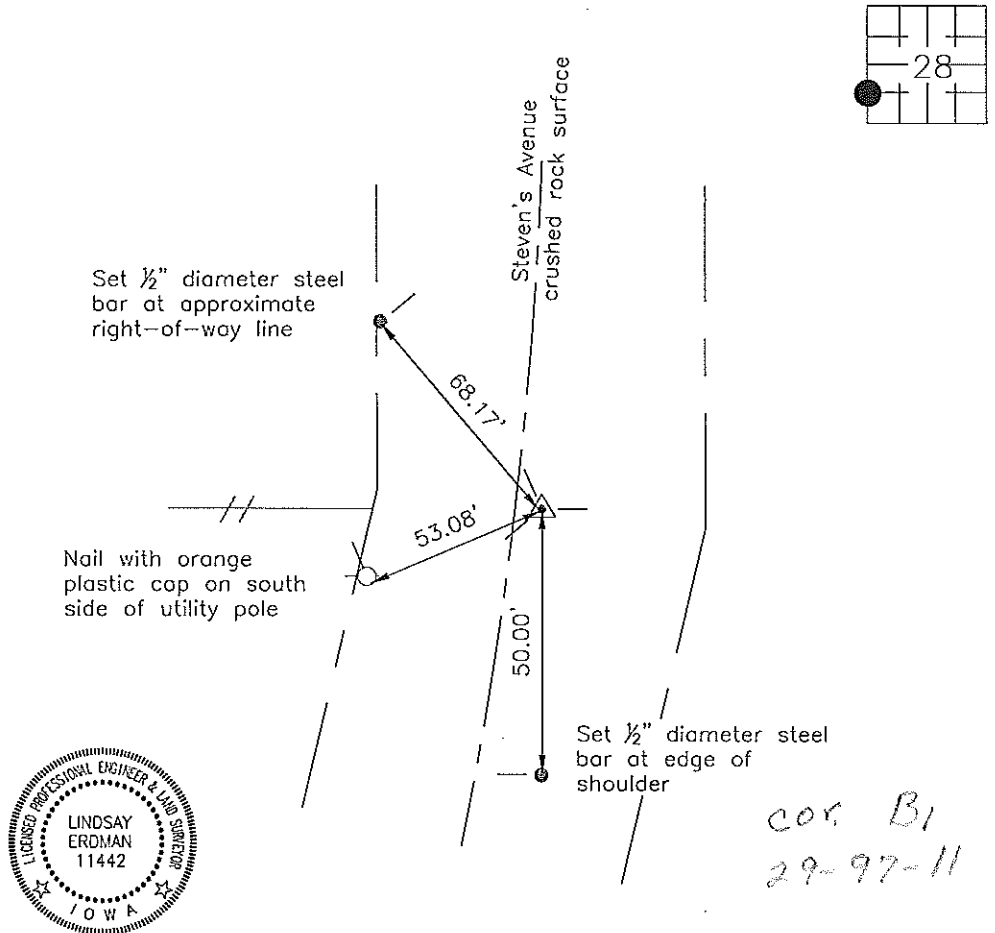

I hereby certify that this land surveying document was prepared and the related survey work was performed by me or under my direct personal supervision and that I am a duly licensed Land Surveyor under the laws of the State of Iowa.

Signature: Lindsay Erdman  
 Lindsay Erdman, P.E. and P.L.S. Iowa License Number 11442

Date: 1/11/13

My license renewal date is December 31, 2014

Corner(s) to be Indexed

Corner	Section	Township	Range
WSW 1/8	28	97	11