

Herold - Reicks Surveying, 10 East Main Street, New Hampton, IA 50655, Ph. 641-394-2725, Fax. 641-394-2718

UNITED STATES PUBLIC LAND SURVEY CORNER CERTIFICATE

Land Survey Monuments situated in Section **31**, Township **97** North, Range **11** West of the Fifth Principal Meridian, **Chickasaw** County, Iowa. Previously recorded in Bk. 158, Pg. 70 in the County Recorder's office.

This certificate is being prepared in compliance with Iowa Code Chapter 355.11 because:




- There is no certificate on file for this corner.
- There are no longer three valid ties of record.
- There are changes to reference ties of record.
- There is change of monumentation of record.
- To clarify description of record monument (ties).

Monument Description and Remarks:

Northeast Corner: Found PK nail with information obtained from previous Section Corner Certificate. Although the same type of monument was recovered for this survey, the County constructed a new HMA overlay since the previous certificate thus yielding a "modified" monument.

PLAN - VIEW

(Show a minimum of three reference ties to durable physical objects, relevant monuments and physical conditions that will enable recovery of the corner.)

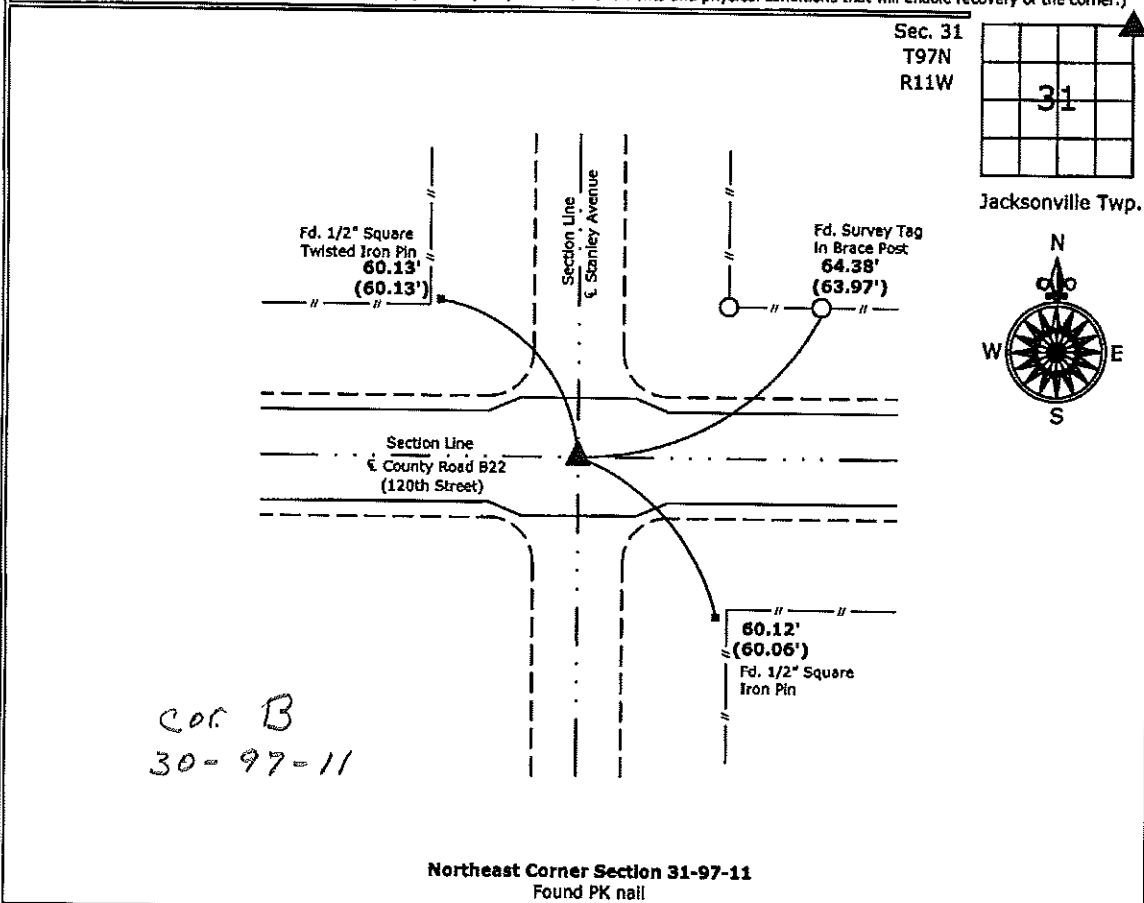

*Cor. B
30-97-11*

Northeast Corner Section 31-97-11
Found PK nail



I hereby certify that this land surveying document was prepared and the related survey work was performed by me or under my direct personal supervision and that I am a duly licensed Land Surveyor under the laws of the State of Iowa.
Kirk D. Reicks 11-30-10
 Kirk D. Reicks Date:
 License number 19211
 My license renewal date is December 31, 2010.
 Sheets covered by this seal: Individual sheet only

List Corners to be Indexed			
Corners	Section	Twp.	Range
NE	31	97	11

Project Number: 2010-102
 FB: Chickasaw County 2, Pgs. 54-55

UNITED STATES PUBLIC LAND SURVEY CORNER CERTIFICATE

OF


Land Survey Monuments situated in Section 29, Township 97 North, Range 11 West, of the Fifth Principal Meridian, Chickasaw County, Iowa.
 Previously recorded in None in County Recorder's Office.
(book, page, document number, etc.)

(Show reason for preparing this certificate, the evidence and detailed procedures used in establishing the corner positions and monumentation found or placed.)

Monument Description and Remarks: E 1/4 Corner, Section 29-T97N-R11W: Found 5/8" Iron Pin 2.6' deep, raised with 1/2" Rebar w/cap.
SW Corner, Section 29-T97N-R11W: Found PK Nail.

PLAN - VIEW

(Show a minimum of three reference ties to durable physical objects, relevant monuments and physical conditions that will enable recovery of the corner.)

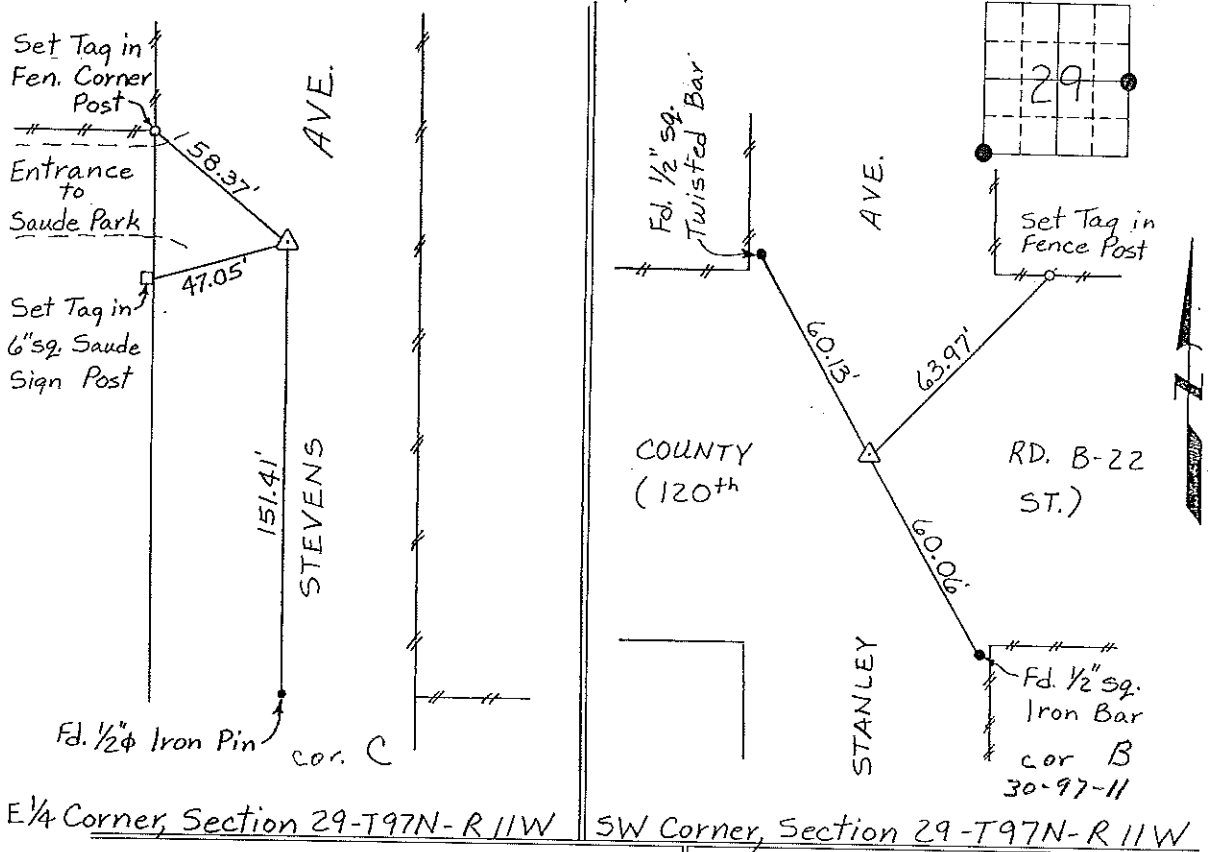

E 1/4 Corner, Section 29-T97N-R 11W


SW Corner, Section 29-T97N-R 11W

I hereby certify that the survey work was completed and this certificate was prepared by me or under my direct personal supervision and that I am a duly registered land surveyor under the laws of the state of Iowa.

Signature: Lyle G. TeKippe
 Lyle G. TeKippe

Date: 5-15-95 Reg. No. 7060
 My Registration Renewal Date is December 31, 1996

Seal

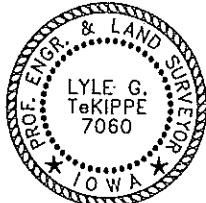

List Corners to be Indexed			
Corners	Section	Twp.	Range
E 1/4	29	97N	11W
cor C	29-97-11		
SW	29	97N	11W
cor B	30-97-11		

*Placed in tie
 book 6/15/95*