

*Herold - Reicks Surveying, 25 1/2 East Main Street, Suite 204, New Hampton, IA 50659, Ph. 641-394-2725*

**UNITED STATES PUBLIC LAND SURVEY CORNER CERTIFICATE**

Land Survey Monuments situated in Section 32, Township 97 North, Range 11 West of the Fifth Principal Meridian, Chickasaw County, Iowa. Not previously recorded in County Recorder's office.

This certificate is being prepared in compliance with Iowa Code Chapter 355.11 because:


1.) & 2.)  There is no certificate on file for this corner.  
 There are no longer three valid ties of record.  
 There are changes to reference ties of record.  
 There is change of monumentation of record.  
 To clarify description of record monument (ties).

**Monument Description and Remarks:**

- 1.) SW Corner NW 1/4-NE 1/4:** Set 5/8"Ø rebar w/2"Ø aluminum cap PLS 19211 equidistant and online between North 1/4 Corner and Center of Section.
- 2.) SW Corner NE 1/4-NE 1/4:** Set 5/8"Ø rebar w/2"Ø aluminum cap PLS 19211 at the intersection of 1/4-1/4 Section Lines.

**PLAN - VIEW**

(Show a minimum of three reference ties to durable physical objects, relevant monuments and physical conditions that will enable recovery of the corner.)

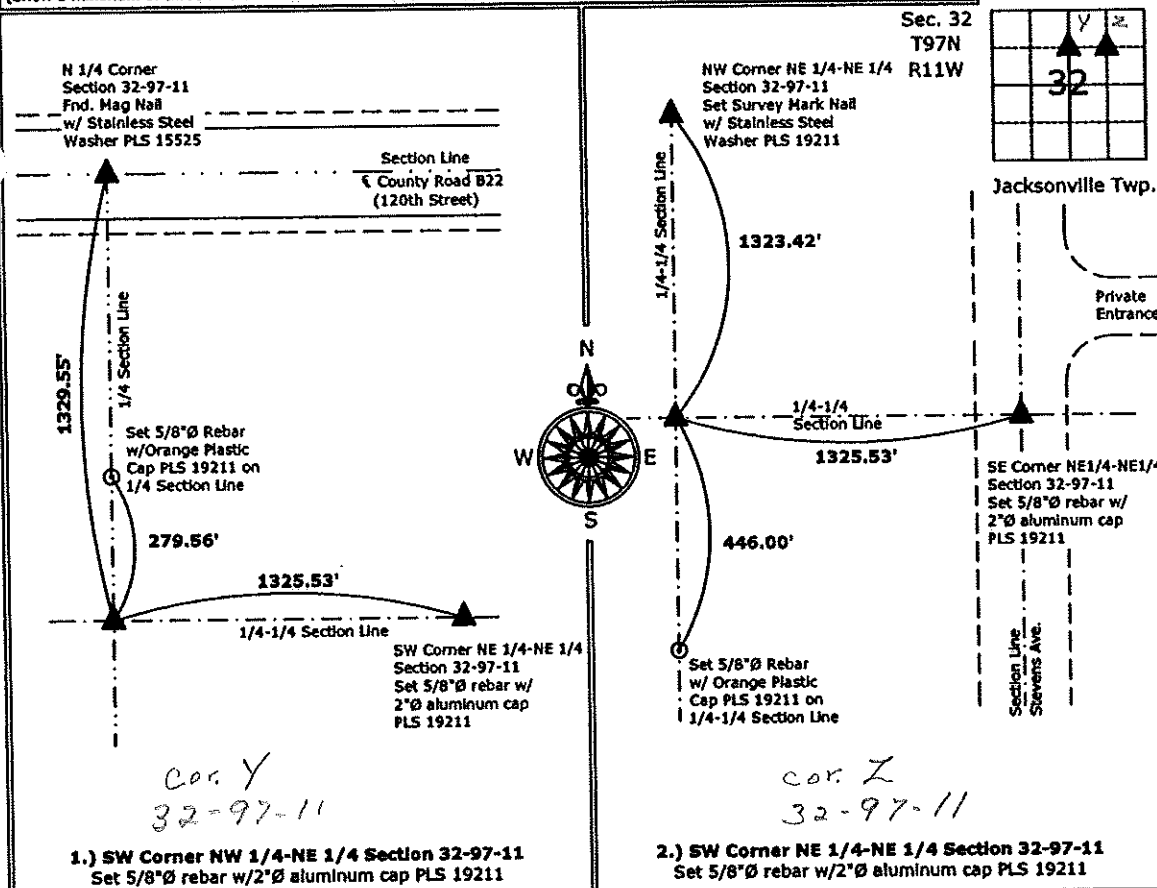

**1.) SW Corner NW 1/4-NE 1/4 Section 32-97-11**  
 Set 5/8"Ø rebar w/2"Ø aluminum cap PLS 19211

**2.) SW Corner NE 1/4-NE 1/4 Section 32-97-11**  
 Set 5/8"Ø rebar w/2"Ø aluminum cap PLS 19211



I hereby certify that this land surveying document was prepared and the related survey work was performed by me or under my direct personal supervision and that I am a duly licensed Land Surveyor under the laws of the State of Iowa.  
*K.D. Reicks 11-2-09*  
 Kirk D. Reicks Date:  
 License number 19211  
 My license renewal date is December 31, 2010.  
 Sheets covered by this seal: Individual sheet only

List Corners to be Indexed			
Corners	Section	Twp.	Range
SW-NW-NE	32	97	11
SW-NE-NE	32	97	11

Project Number: 2009-134  
 FB: Chickasaw County 1, Pg. 22

File: S:\Projects\2009-134\img\2009-134.dwg, 11/27/2009 1:34:56 PM