

prepared by & Return to: Harold - Reicks Surveying, 10 East Main Street, New Hampton, IA 50659, Ph. 641-394-2725

**UNITED STATES PUBLIC LAND SURVEY CORNER CERTIFICATE**

Land Survey Monuments situated in Section **34**, Township **97** North, Range **11** West of the Fifth Principal Meridian, **Chickasaw** County, Iowa. Not previously recorded in the County Recorder's office.

This certificate is being prepared in compliance with Iowa Code Chapter 355.11 because:


1 & 2  There is no certificate on file for this corner.  
 There are no longer three valid ties of record.  
 There are changes to reference ties of record.  
 There is change of monumentation of record.  
 To clarify description of record monument (ties).

**Monument Description and Remarks:**

- Southwest Corner NW 1/4-SE 1/4 :** Set 5/8"Ø rebar w/2"Ø aluminum cap PLS 19211 equidistant and on line between the South 1/4 Corner and Center of Section 34.
- Southeast Corner NE 1/4-SE 1/4:** Set 5/8"Ø rebar w/2"Ø aluminum cap PLS 19211 equidistant and on line between the East 1/4 and Southeast Corners of Section 34.

**PLAN - VIEW**

(Show a minimum of three reference ties to durable physical objects, relevant monuments and physical conditions that will enable recovery of the corner.)

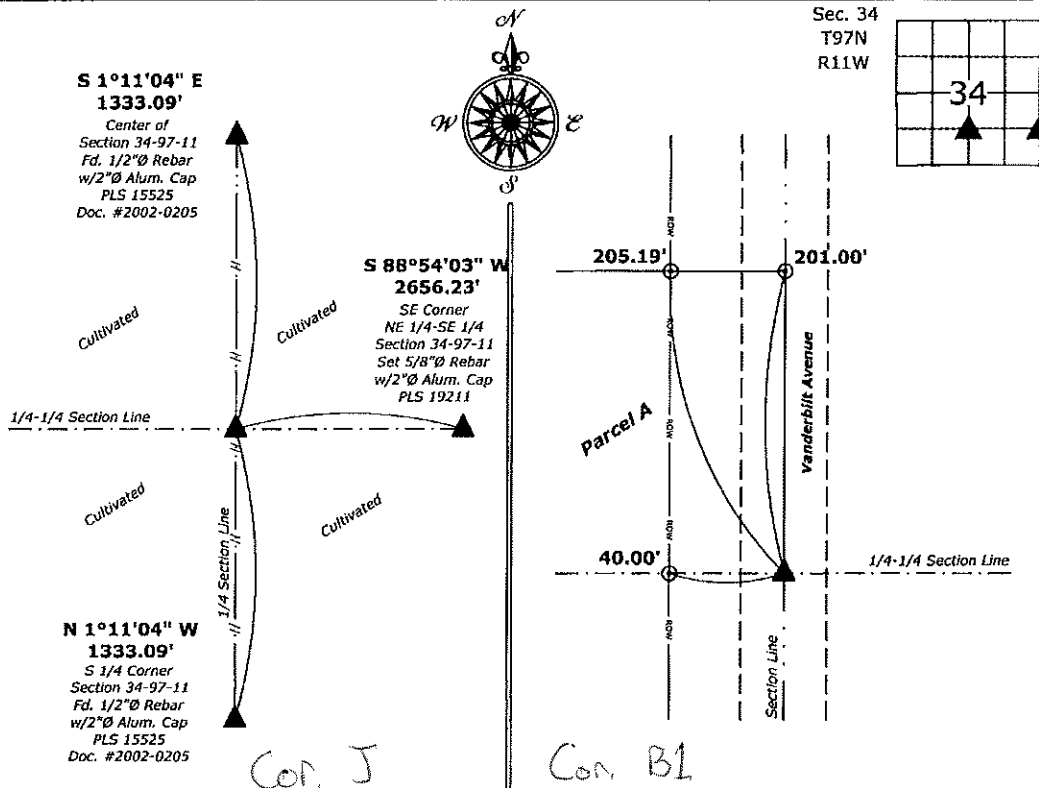

- Southwest Corner NW 1/4-SE 1/4 Section 34-97-11**  
Set 5/8"Ø rebar w/2"Ø aluminum cap PLS 19211
- Southeast Corner NE 1/4-SE 1/4 Section 34-97-11**  
Set 5/8"Ø rebar w/2"Ø aluminum cap PLS 19211



I hereby certify that this land surveying document was prepared and the related survey work was performed by me or under my direct personal supervision and that I am a duly licensed Land Surveyor under the laws of the State of Iowa.

*Kirk D. Reicks 9-29-16*  
 Kirk D. Reicks Date:  
 License number 19211  
 My license renewal date is December 31, 2016.  
 Sheets covered by this seal: Individual sheet only

List Corners to be Indexed			
Corners	Section	Twp.	Range
SW-NW-SE	34	97	11
SE-NE-SE	34	97	11

Project Number: 2016-126  
 FB: Chickasaw County 8, Pg. 10

File: S:\\_C3D Projects\County Control Systems\CHICKASAW\CHICK-8\CHICK-8.dwg, 9/28/2016 5:03:50 PM