

Corner A:
 Section 25-97-11
 As referred to in
 Engr. Tie Book

FILED 2005 - 2064
 RECORDER'S OFFICE
 CHICKASAW COUNTY, IOWA
Fee #700
 2005 SEP 21 AM 8 36
 CINDY MESSERSMITH
 COUNTY RECORDER

TeKIPPE ENGINEERING, P.C., 128 South Vine Street, West Union, Iowa 52175 Phone (563) 422-5131

UNITED STATES PUBLIC LAND SURVEY CORNER CERTIFICATE

OF 25

Land Survey Monuments situated in Section 36, Township 97 North, Range 11 West of the Fifth Principal Meridian, CHICKASAW County, Iowa.
 Previously recorded in none in County Recorder's Office.
 (book, page, document number, etc.)


(Show reason for preparing this certificate, the evidence and detailed procedures used in establishing the corner positions and monumentation found or placed.)

Monument Description and Remarks: N 1/4 CORNER SECTION 36 T97N R11W: Found 5/8"Ø pipe w/aluminum cap 2886 with information obtained from a Survey and Plat made by L. P. Erdman recorded in the Chickasaw County Recorder's Office December 15, 1987 in Book 139, Page 378.

S 1/4 CORNER SECTION 36 T97N R11W: Set 1/2"Ø rebar w/2"Ø aluminum cap PLS 16961 in middle of area encompassed by three corner posts.

PLAN - VIEW

(Show a minimum of three reference ties to durable physical objects, relevant monuments and physical conditions that will enable recovery of the corner.)

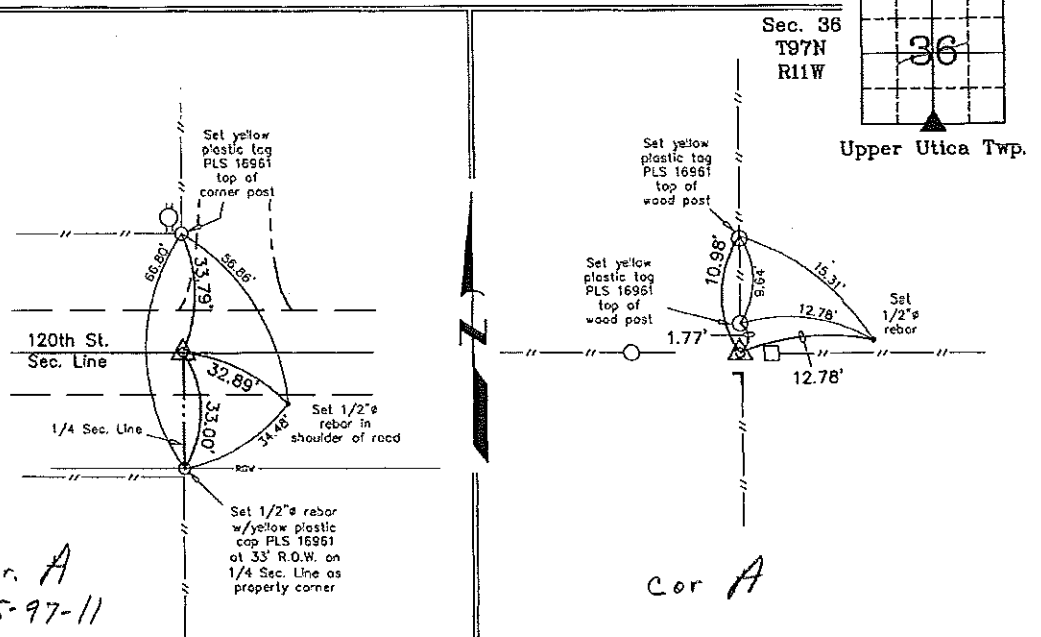

Cor. A
 25-97-11

Cor A

N 1/4 Corner Section 36 T97N R11W
 Found 5/8"Ø pipe w/aluminum cap 2886

S 1/4 Corner Section 36 T97N R11W
 Set 1/2"Ø rebar w/2"Ø aluminum cap PLS 16961



I hereby certify that this land surveying document was prepared and the related survey work was performed by me or under my direct personal supervision and that I am a duly licensed Land Surveyor under the laws of the State of Iowa.
Michael J. Shimak *October 19, 2005*
 Michael J. Shimak Date
 License number 16961
 My license renewal date is December 31, 2006.
 Sheets covered by this seal: Individual

List Corners to be Indexed			
Corners	Section	Twp.	Range
N 1/4	36	97N	11W
S 1/4	36	97N	11W

Project Number 05183.LS
 FR. 46L PG. 50-51
 X:\Section Corners\Sec. 36\36-97-11cw.dwg