

Chickasaw Co. Recorder  
 Cindy Messersmith  
 Fee Book 2012-1580  
 08/10/2012 @1012AM  
 SCC SEC COR CERT  
 Book: Page: # Pages: 1  
 Total Fees: \$7.00

Prepared by & Return to Harold - Reeks Surveying, 18 East Main Street, New Hampton, IA 50659, Ph. 641-394-2725

### UNITED STATES PUBLIC LAND SURVEY CORNER CERTIFICATE

Land Survey Monuments situated in Section 7, Township 96 North, Range 13 West of the Fifth Principal Meridian, Chickasaw County, Iowa. Previously recorded in Bk. 161, Pg. 159 in the County Recorder's office.

This certificate is being prepared in compliance with Iowa Code Chapter 355.11 because:


- {  There is no certificate on file for this corner.  
 There are no longer three valid ties of record.  
 There are changes to reference ties of record.  
 There is change of monumentation of record.  
 To clarify description of record monument (ties).

Monument Description and Remarks:


**Southeast Corner:** Found drilled hole from the record location as shown on a survey and plat recorded as Bk. 165, Pg. 420. Added Cut "X" to make monument more visible and tied out corner.

### PLAN - VIEW

(Show a minimum of three reference ties to durable physical objects, relevant monuments and physical conditions that will enable recovery of the corner.)

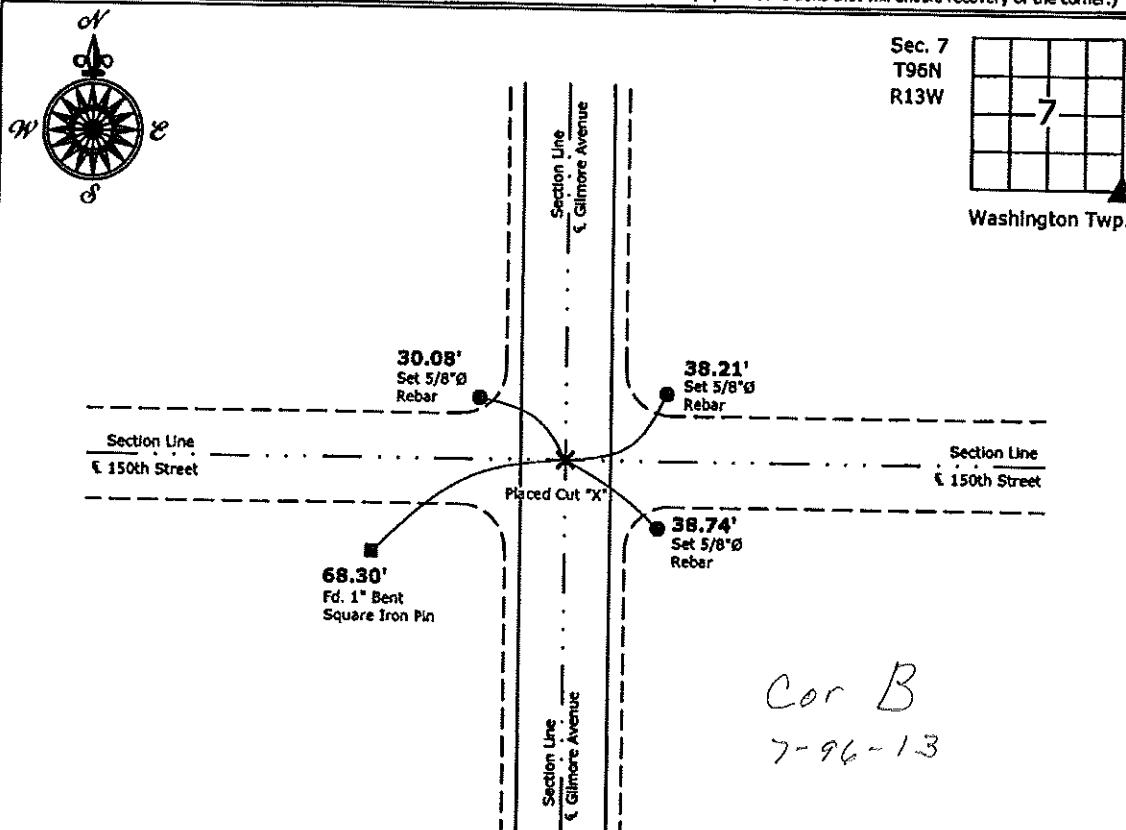

Southeast Corner Section 7-96-13  
 Fd. Drilled Hole in Pavement

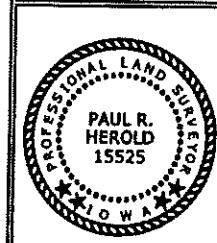

I hereby certify that this land surveying document was prepared and the related survey work was performed by me or under my direct personal supervision and that I am a duly licensed Land Surveyor under the laws of the State of Iowa.

Paul R. Herold 8-8-12

Date:

License number 15525

My license renewal date is December 31, 2012.  
 Sheets covered by this seal: Individual sheet only

List Corners to be Indexed			
Corners	Section	Twp.	Range
SE	7	96	13

Project Number: 2012-135

FB: Chickasaw County 4, Pg. 50

## UNITED STATES PUBLIC LAND SURVEY CORNER CERTIFICATE

SLSI 9-94

OF

Land Survey Monuments situated in Section 17, Township 96 N, Range 13 W, of the Fifth Principal Meridian, CHICKASAW County, Iowa.  
 Previously recorded in NIA in County Recorder's Office.


(Show reason for preparing this certificate, the evidence and detailed procedures used in establishing the corner positions and monumentation found or placed.)

Monument Description and Remarks:

SET CORNERS LISTED BELOW BY  
EXISTING TIES.

## PLAN - VIEW

(Show a minimum of three reference ties to durable physical objects, relevant monuments and physical conditions that will enable recovery of the corner.)

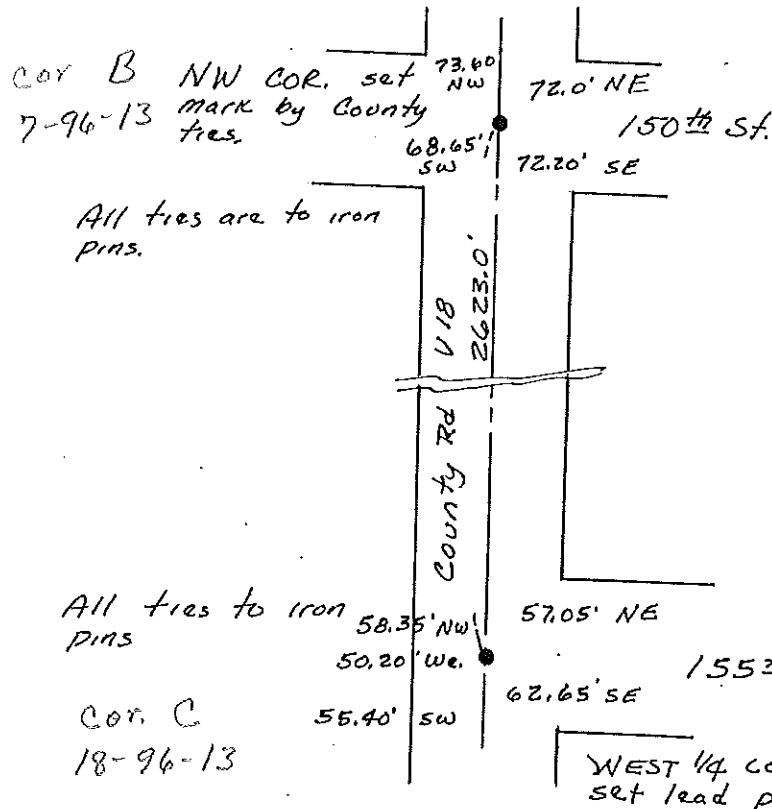

I hereby certify that the survey work was completed, and this land surveying document was prepared by me or under my direct personal supervision and that I am a duly registered land surveyor under the laws of the state of Iowa.

Signature: Steve Busse  
 Name typed or printed: STEVE BUSSE

Date: 6/17/96 Reg. No. 9018

My registration renewal date is December 31, 1996

Corners	Section	Twp	Range
NW	17	96	13 } B
NE	18	96	13 } 7-8
W 1/4	17	96	13 } C
E 1/4	18	96	13 } 18-9

SEAL

Steve Busse  
 PLS 6/17/96