

Prepared by & Return to Herold - Recks Surveying, 10 East Main Street, New Hampton, IA 50659, Ph. 641-394-2725

UNITED STATES PUBLIC LAND SURVEY CORNER CERTIFICATE

Land Survey Monuments situated in Section 19, Township 96 North, Range 13 West of the Fifth Principal Meridian, Chickasaw County, Iowa. 1., 2.) Not previously recorded in the County Recorder's office.

This certificate is being prepared in compliance with Iowa Code Chapter 355.11 because:

- 1 & 2 There is no certificate on file for this corner.
 There are no longer three valid ties of record.
 There are changes to reference ties of record.
 There is change of monumentation of record.
 To clarify description of record monument (ties).


Monument Description and Remarks:

1.) **West 1/4 Corner:** Set 5/8"Ø rebar with 2"Ø aluminum Cap PLS 15525 from use of possession line fences in conjunction with information obtained from a survey and plat made by G.W. Cotant on file in Range Bk. 12-13, Section 19 in the County Engineer's office and the associated field notes, on file in Field Note & Certificate Bk. A, Pg. 131.

2.) **Center of Section:** Set 5/8"Ø rebar with 2"Ø aluminum Cap PLS 15525 at the intersection of 1/4 Section Lines.

PLAN - VIEW

(Show a minimum of three reference ties to durable physical objects, relevant monuments and physical conditions that will enable recovery of the corner.)

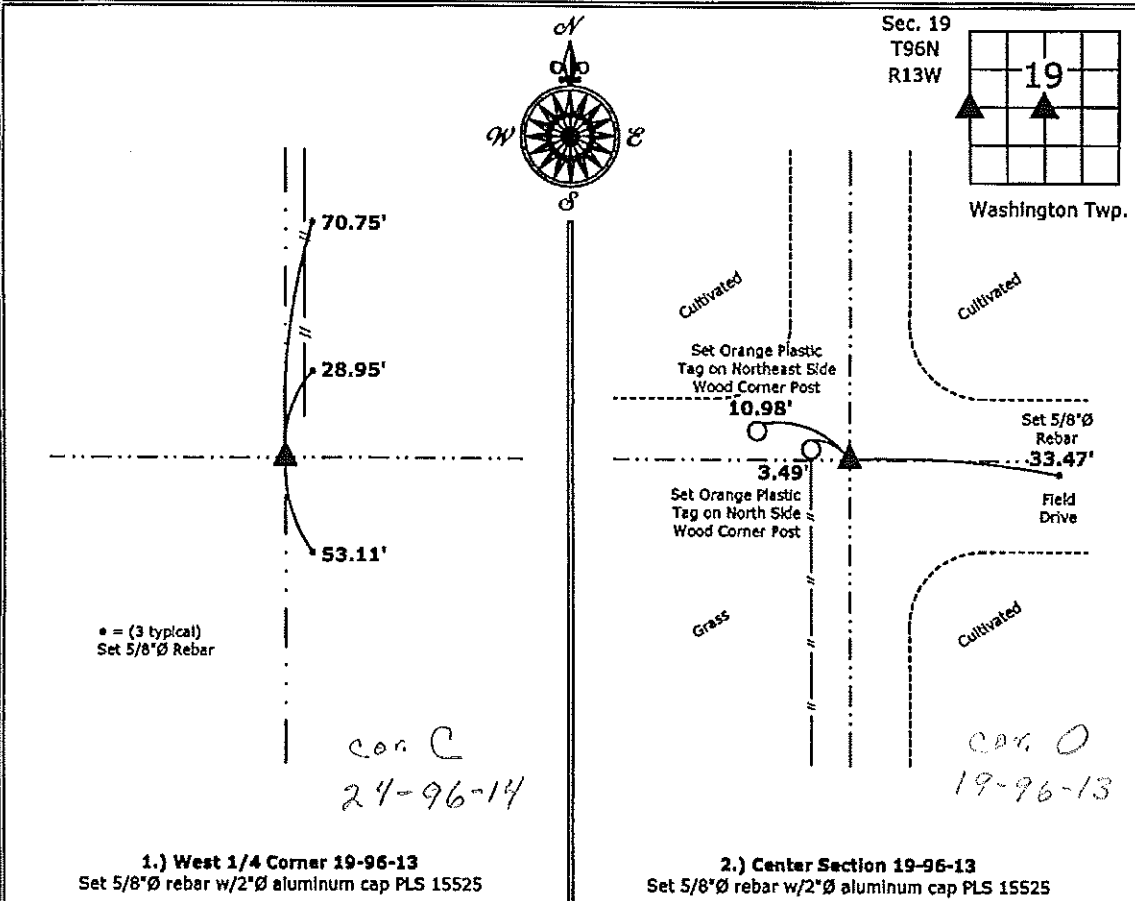

1.) **West 1/4 Corner 19-96-13**
 Set 5/8"Ø rebar w/2"Ø aluminum cap PLS 15525

2.) **Center Section 19-96-13**
 Set 5/8"Ø rebar w/2"Ø aluminum cap PLS 15525



I hereby certify that this land surveying document was prepared and the related survey work was performed by me or under my direct personal supervision and that I am a duly licensed Land Surveyor under the laws of the State of Iowa.

Paul R. Herold 9-18-12
 Paul R. Herold Date:

License number 15525
 My license renewal date is December 31, 2012.
 Sheets covered by this seal: Individual sheet only

List Corners to be Indexed

Corners	Section	Twp.	Range
W 1/4	19	96	13
CTR	19	96	13

Project Number: 2012-151

FB: Chickasaw Co. 4, Pgs. 55