

Section 19-96-13
As referred to in
Ength Tie Book.

Chickasaw Co. Recorder
Cindy Messersmith
Fee Book 2007-1452
07/13/2007 @0132PM
SCC SEC COR CERT
Book: Page: # Pages: 1
Total Fees: \$7.00

PREPARED BY : North Star Land Surveyors, 107 Pine Street, New Hampton, IA 50659, Phone : 641-394-3448

UNITED STATES PUBLIC LAND CORNER CERTIFICATE

OF: 19

Land Survey Monuments situated in Section 20, Township 96 North, Range 13 West
of the Fifth Principal Meridian, Chickasaw County, Iowa. Previously recorded in
none in Office of County Recorder.


(book, page, document number, etc.)

(Show reason for preparing this certificate, the evidence and detailed procedures used in establishing the corner positions and
monumentation found or placed.)

Monument Description and Remarks :


W 1/4 Section 20 Twp. 96 Rng. 13 W. : Found PK nail in cut "x". Measurement to houses match reference ties in
County Engineer's fieldbook. New distance to Spike in H.L.P.

SW Corner Section 20 Twp. 96 Rng. 13 W. : Found PK nail in Conc. Pavement per County Engineer's fieldbook. Set
new tie in top "North Washington" sign bracepost.

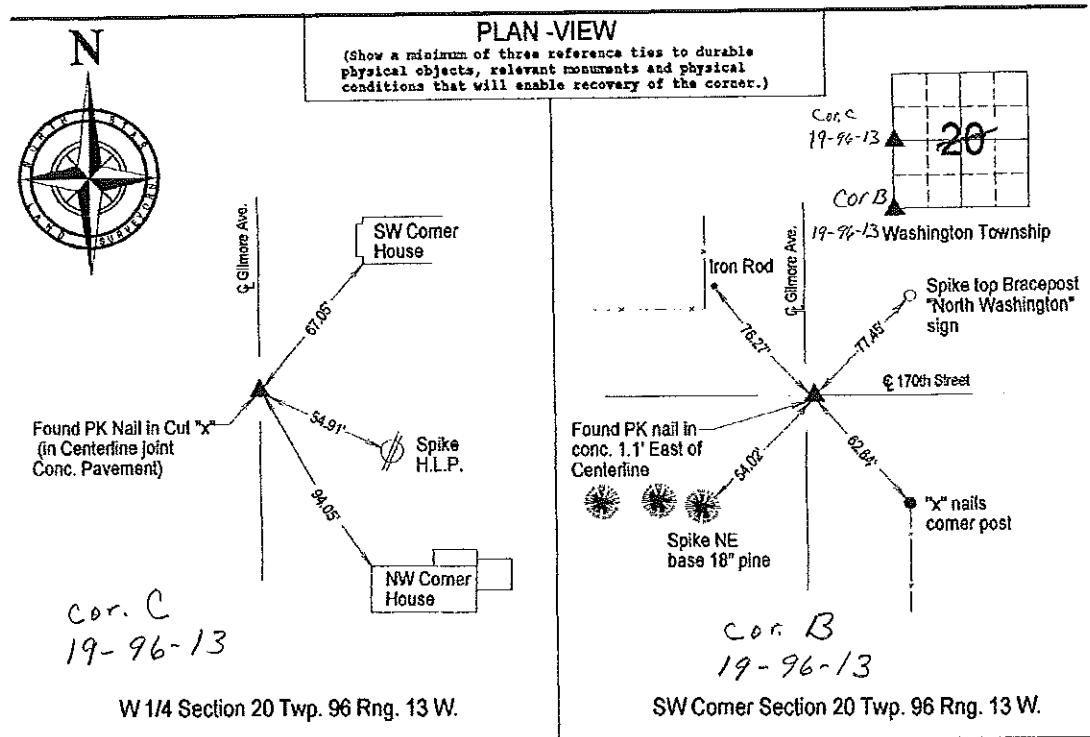

W 1/4 Section 20 Twp. 96 Rng. 13 W.

SW Corner Section 20 Twp. 96 Rng. 13 W.

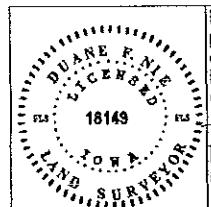

I hereby certify that this land surveying document was prepared and the related survey work was performed by me or under my direct personal supervision and that I am a duly LICENSED LAND SURVEYOR under the laws of the State of IOWA.
Duane F. Nie July 11, 2007
Duane F. Nie License number 18149
My license renewal date is December 31, 2008
Pages or sheets covered by this seal. This page only 1807001-1807005

List Corners to be Indexed

Corner	Section	Township	Range
W 1/4	20	96	13
SW	20	96	13