

Chickasaw Co. Recorder  
 Cindy Messersmith  
**Fee Book 2012-1830**  
 09/19/2012 00834AM  
 SEC COR CERT  
 Book: Page: # Pages: 1  
 Total Fees: \$7.00

Prepared by & Return to: Herald - Recka Surveying, 10 East Main Street, New Hampton, IA 50659, Ph: 641-394-2725

### UNITED STATES PUBLIC LAND SURVEY CORNER CERTIFICATE

Land Survey Monuments situated in Section 19, Township 96 North, Range 13 West of the Fifth Principal Meridian, Chickasaw County, Iowa. Not previously recorded in the County Recorder's office.

This certificate is being prepared in compliance with Iowa Code Chapter 355.11 because:


There is no certificate on file for this corner.  
 There are no longer three valid ties of record.  
 There are changes to reference ties of record.  
 There is change of monumentation of record.  
 To clarify description of record monument (ties).

Monument Description and Remarks:


**Northeast Corner SW 1/4-NE 1/4:** Set 5/8"Ø rebar with 2"Ø aluminum Cap PLS 15525 equidistant and on line between the North 1/4 Corner and Center of Section 19, A search for the previous T-Bar was unsuccessful.

### PLAN - VIEW

(Show a minimum of three reference ties to durable physical objects, relevant monuments and physical conditions that will enable recovery of the corner.)

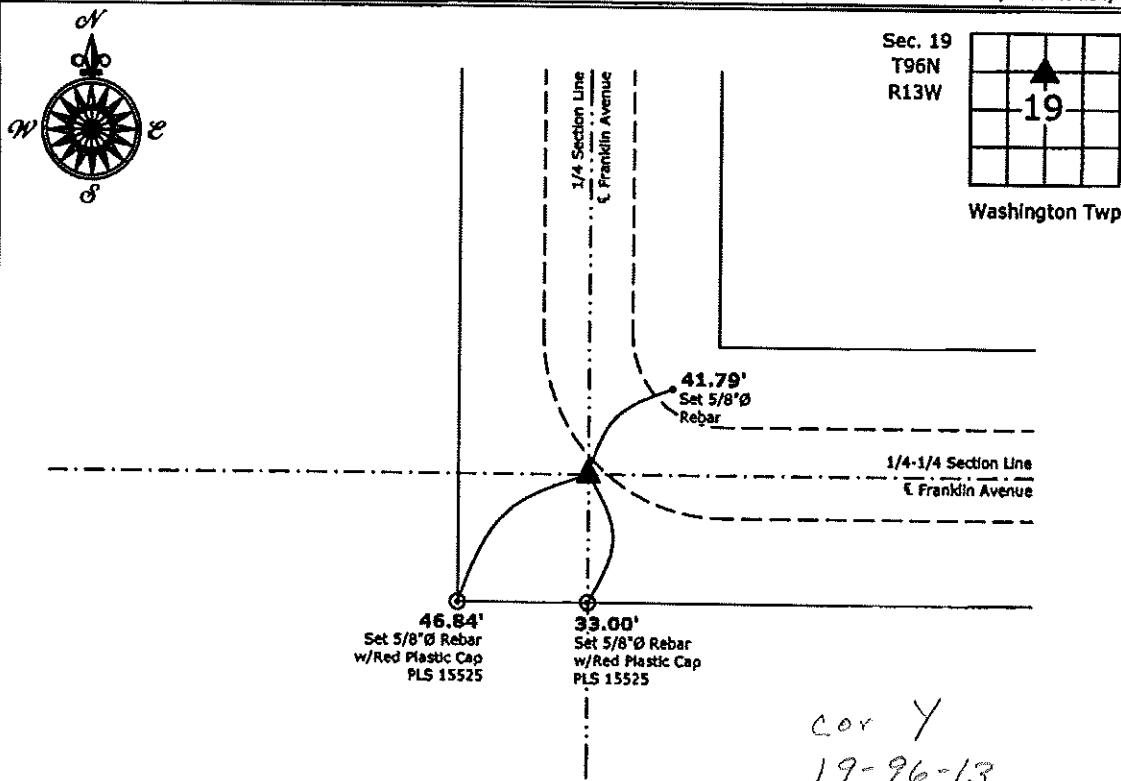

**Northeast Corner SW 1/4-NE 1/4 Section 19-96-13**  
 Set 5/8"Ø rebar w/2"Ø aluminum cap PLS 15525

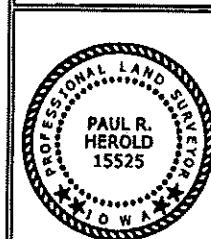

I hereby certify that this land surveying document was prepared and the related survey work was performed by me or under my direct personal supervision and that I am a duly licensed Land Surveyor under the laws of the State of Iowa.

*Paul R. Herold 9-12-12*

Paul R. Herold  
Date:

License number 15525

My license renewal date is December 31, 2012.  
 Sheets covered by this seal: Individual sheet only

List Corners to be Indexed			
Corners	Section	Twp.	Range
NE-SE-NW	19	96	13

Project Number: 2012-151

FB: Chickasaw Co. 4, Pgs. 55