Section 17-96-13 As referred to in Ensi. The Book

Chickasaw Co. Recorder Cindy Messersmith Fee Book 2008-2122 11/05/2008 @1054AM SCC SEC COR CERT Book: Page: Total Fees: \$7.00 # Pages: 1

Herold - Reacks Surveying, 25 1/2 East Main Street, Suite 2011, New Hompton, 19 50659, Ph. 641-991-2725

## UNITED STATES PUBLIC LAND SURVEY CORNER CERTIFICATE

Land Survey Monuments situated in Section 20, Township 96 North, Range 13 West of the Fifth Principal Meridian, Chickasaw County, Iowa. Previously recorded in 1.) Bk. 151, Pg. 183 in the Chickasaw County Recorder's office, 2.) Previously not Recorded.

This certificate is being prepared in compliance with Iowa Code Chapter 355.11 because:

Monument Description and Remarks:


There is no certificate on file for this comer. There are no longer three valid ties of record.

1. 🛛 There are changes to reference ties of record.

There is change of monumentation of record.

1. X To clarify description of record monument (ties).

- 1.) N 1/4 Corner Section 20-96-13: Fd. 1/2"Ø rebar from information on the previous Section Corner certificate, previous information indicated a 1/2"Ø bar w/Cap, the cap is missing as well as all of the ties, set 3 ties to update the
- 2.) SE Corner NE 1/4-NW 1/4 Section 20-96-13: Set 5/8"Ø rebar w/2"Ø aluminum cap PLS 15525 equidistant and on line between the N 1/4 Corner and the Center of Section, there is no record of the perpetuation of a monument at this Corner position.

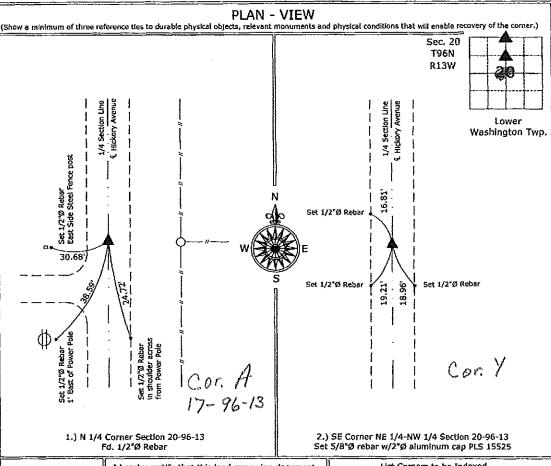

I hereby certify that this land surveying document was prepared and the related survey work was performed by me or under my direct personal supervision and that I am a duly licensed Land Surveyor under the laws of the State of Iowa.

ForeR. Heroed 11-5-08 Paul R. Herold License number 15525

My license renewal date is December 31, 2008. Sheets covered by this seal: Individual sheet only

List Comers to be Indexed				
Corners	Section	Тур.	Range	
N 1/4	20	96	13	
SE-NE-NW	20	96	13	

Projects\2008\2008-114\dwg\2008-114.dwg, 11/5/2008 08:36

Project Number: 2008-114 FB: North Washington 1, Pgs. 1-3

## UNITED STATES PUBLIC LAND SURVEY CORNER CERTIFICATE

OF

tation found or placed.)	edures used in establishing the corner positions and monu-
PLAN - VIE	241
ow a minimum of three reference ties to durable physical objects, release of the corner.)	vant monuments and physical conditions that will enable
まCORNER CENTER SECTION のき"BAR W/CAP FD. ま"BAR.	ET COPNER
	FOE BAR W/CAP
NAU IN E. SID POWER POLE	COLNER POST
	STEER NO POWER POLE N
Cor H	
NAW IN FENCE POST	Cor. C
NAIL IN N. SIDE PONIGEPOLE	, 55, 1 , 5, 1 , 5, 1 , 5, 1 , 7
Con 0	NAIL N. SIDE
NAIL IN N SIDE CORNE	COENCE POST
	,
I hereby certify that the survey work was completed and this certifical was prepared by me or under my direct personal supervision and that I am a duly registered land surveyor under the laws of the state of	Comers Section 1 wp Range
lowa,	C5 17 96 13 0 h.
Name typed or printed: L.P. EEOMOV  Date: 12-02-92 Reg. No. 286	JE4 17 96 13 CT
ERD MAN	flored en tro book 2/22/93
SEAL 2886	100 2/93
2000	Jode of
CR. & LAND	12